16 TOWN

ADAMS COUNTY COUNTY CORNER NO: 59

ROMPORTOL ID: 41607142000

PUBLIC LAND SURVEY MONUMENT RECORD

HARRISON TYPE OF MONUMENT: ADAMS COUNTY COORDINATES, NAD 83 (2007)

N. 183293.131

F. 583880.927


ELEVATION- - - DATUM

09/17/2020 FIELD WORK DATE:


BASIS FOR MONUMENT LOCATION

1977 - PLS 878 NO RESURVEYS OF RECORD. EXCAVATED WITH BACKHOE 10 TO 25 FEET EAST OF EXISTING IRON PIPE. FOUND NOTHING. ACCORDING TO ADJACENT LANDOWNER, ROAD WAS SHIFTED TO WEST TO BYPASS FARM BUILDINGS. THERE IS A NOTICEABLE BEND IN THE ROAD NORTH OF HERE. CORNER WAS SET ON LINE AND EQUIDISTANT BETWEEN SECTION CORNERS.

2020 - PLS 2675 FOUND HARRISON 8"± BELOW THE ROAD SURFACE AND 1 TIE. THE MONUMENT AGREES WITH THE EXISTING TIE AND IS ON A NEAR STRAIGHT LINE AND EQUIDISTANT SPLIT FROM THE SE AND NE CORNERS OF SECTION 14. ACCEPTED THE HARRISON AS THE CORNER LOCATION. SET 3 NEW TIES AND MEASURED TO THE EXISTING TIE AND FOUND PROPERTY IRON.

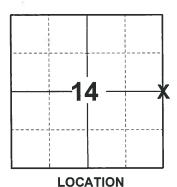

(INDICATE CORNER BY "X")

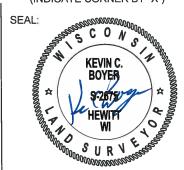

DATA SHOWN HERE ON THIS TIE SHEET IS CORRECT AND COMPLETE TO THE BEST OF MY KNOWLEDGE AND BELIEF.

PROFESSIONAL LAND SURVEYOR


DATE

-TIE SKETCH

NOTE: THE CORNER LANDS 17.1'± EAST OF 2ND AVE. CENTERLINE AND 1.2'± SOUTH OF EDGEWOOD DR. CENTERLINE.




- SET 3/4" x 18" IRON REBAR, 1.50#/FT
- FOUND 1-1/4" O.D. IRON PIPE
- FOUND 3/4" IRON ROD
- FOUND HARRISON MONUMENT
- STEEL FENCE POST
- VINYL "T" POST

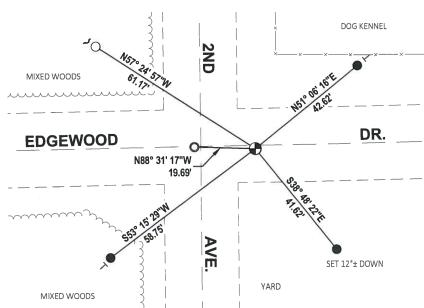

Government Land Corner Certificate

ADAMS County	
TYPE OF MONUMENT: ZRSTIKE (TONE) HARRISON	
STATE PLANE COORDINATES: N	-
F	
ELEVATION — M.S.L. DATUM:	<u>r</u>
THETA ANGLE:	
FIELD BOOK: 57 PAGE 52	
DRAWN BY: Scott SORENSEN	

CORNER NO. 59 SECTION 14 TOWN 16 RANGE 7

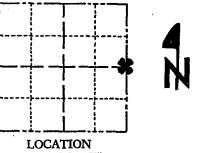


BASIS FOR MONUMENT LOCATION

Show info such as: History of corner, with reference to Vol. and pg., dates, surveyor; exact description of monument replaced; if location computed, by taped or EDM traverse; landowner remarks, etc. (Use reverse side if necessary)

No resurveys of record. Excavated with backhoe 10 to 25 feet east of existing iron pipe. Found nothing. According to adjacent landowner, road was shifted to the west to bypass farm buildings. There is a noticable bend in the road north of here. Corner was set on line equidistant between section corners.

9.20-82 GR-SS OK 12-12-86 GR OK 12-73-91 KZ-SS "1 1-CONE, 1-NEW 1-15-97 JG-SS 1-02-02 ML OK 0K, 2-20-07-36

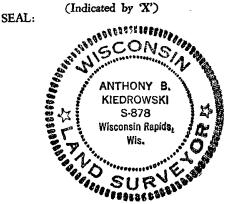

DATA SHOWN HERE ON CERTIFIED CORRECT:

| Long | Colored |
| Registered Land Surfeyor |
| DATE: 12/8/77

TIE SKETCH

Show at least four ties, also fence lines, roads, topo, size and type of witness trees' and if off road - best way to arrive at corner.

Ties are to nail nad disc.

POWER POLE GONE 97' NAIL 3' HIGH 2"EIM/ 2416H QEDGE WOOD DRIVE 19.6>-EXISTING TRON PIPE EE POWER POLE POWER NAIL 3'HIGH POLE

MAINTENANCE RECORD

Date	Init.	Remarks
01-23-12	MS	ok
		,