16 TOWN

OT ADAMS COUNTY COUNTY


PUBLIC LAND SURVEY MONUMENT RECORD

TYPE OF MONUMENT:	HARRISON	
ADAMS COUNTY COORDIN	IATES, NAD 83 (2007)	
N. 180652.35	59	(9)
E_ 586525.462		
ELEVATION	DATUM — —	
FIELD WORK DATE: 09/15/2020		

BASIS FOR MONUMENT LOCATION

1977 - PLS 1103 RAN EDM/T2 TRAVERSE AROUND SECTIONS 1, AND 12, AND PORTIONS OF SECTION 13 TO DETERMINE SEARCH AREA FOR INVESTIGATION. EXCAVATION YIELDED 2"X30" IRON PIPE OF UNKNOWN ORIGIN, AND NO OTHER EVIDENCE OF THE ORIGINAL CORNER OR ANY REMONUMENTATION ON THIS CORNER, ACCEPTED PIPE AS CORNER AND REMONUMENTED WITH HARRISON MONUMENT.

2020 - PLS 2675 FOUND HARRISON 4"± BELOW THE ROAD SURFACE AND 2 WITNESSES. THE MONUMENT AGREES WITH BOTH WITNESSES. ACCEPTED THE HARRISON AS THE CORNER LOCATION. SET 4 NEW TIES AND MEASURED TO THE EXISTING WITNESSES.

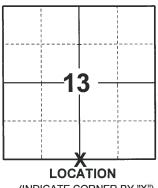

(INDICATE CORNER BY "X")




DATA SHOWN HERE ON THIS TIE SHEET IS CORRECT AND COMPLETE TO THE BEST OF MY KNOWLEDGE AND BELIEF.

PROFESSIONAL LAND SURVEYOR

-TIE SKETCH

NOTE: THE CORNER LANDS 6'± SOUTH OF ELK AVE. CENTERLINE.



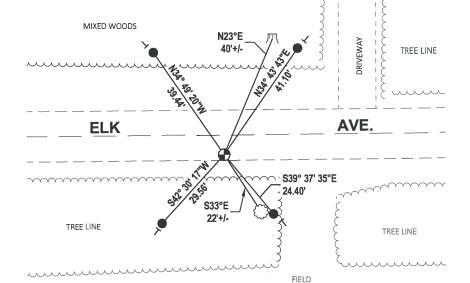

- SET 3/4" x 18" IRON REBAR, 1.50#/FT
- FOUND HARRISON MONUMENT
- WITNESS STUMP
- VINYL "T" POST
- WITNESS TREE

CORNER NO. ADAMS COUNTY SECTION Survey Monument Record 16 TOWN TYPE OF MONUMENT: ___ Harrison RANGE STATE PLANE COORDINATES: N. E ELEVATION - M.S.L. DATUM: _ THETA ANGLE: __ FIELD BOOK: _____ __ PAGE _ BASIS FOR MONUMENT LOCATION (Use reverse side if necessary) Show info such as: History of corner, with reference to Vol. and pg, dates, surveyor; exact description of monument replaced; if location computed, by taped or EDM traverse; landowner SEAL: Ran EDM/T2 traverse around Sections 1, and 12, and portions of Section 13 to determine search area for investigation. Excavation yielded 2"x30" Iron Pipe of unknown origin, and no other evidence of the original corner or any remonumentation on this corner. Accepted Pipe as corner and remonumented with Harrison Monument. 4-13.82 6R-55 COR 015 12-12-86 CERTIFIED CORRECT 12-23-91 ALL OK 12-11-96 56-55 Registered Land Surveyor 1-09-02 ML-EC OK DATE: 5-31-77 -20-06- 56 01-25-12 TIE SKETCH GONE (Show at least four ties) GONE 144Black NOTE 30'8/K Ties in trees to nail in disc.