# OT ADAMS COUNTY COUNTY CORNER NO: 77

ROMPORTOL ID: 41607212000

## PUBLIC LAND SURVEY MONUMENT RECORD


**HARRISON** TYPE OF MONUMENT: ADAMS COUNTY COORDINATES, NAD 83 (2007) N. 177997.354 E. 573302.454 - -- DATUM\_ **ELEVATION-\_** 

08/27/2020 FIELD WORK DATE:


#### BASIS FOR MONUMENT LOCATION

1976 - PLS 1103 RAN EDM/T2 TRAVERSE FROM NORTHEAST CORNER OF SECTION 21 TO THE SOUTHEAST CORNER OF SECTION 21 IN SEARCH OF THE EAST QUARTER CORNER. FOUND NO EVIDENCE OF THE ORIGINAL CORNER WITHIN THE SEARCH AREA, BUT DID FIND REMONUMENTATION IN THE FORM OF A 3/4" BY 24" IRON BAR, WHICH FIT THE POSSESSION WELL. REMONUMENTED THE BAR FOUND WITH A HARRISON MONUMENT.

2020 - PLS 2675 FOUND HARRISON FLUSH WITH THE GROUND AND DID NOT RECOVER ANY EXISTING TIES OR WITNESSES. ACCEPTED THE HARRISON AS THE BEST AVAILABLE EVIDENCE OF THE CORNER LOCATION AND SET 4 NEW TIES.

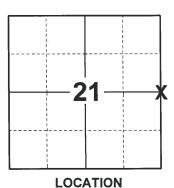

(INDICATE CORNER BY "X")

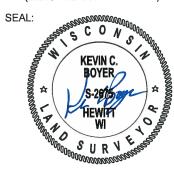

DATA SHOWN HERE ON THIS TIE SHEET IS CORRECT AND COMPLETE TO THE BEST OF MY KNOWLEDGE AND BELIEF.


PROFESSIONAL LAND SURVEYOR

DATE

#### -TIE SKETCH

NOTE: ROCKS ARE PILED AROUND THE CORNER MONUMENT.



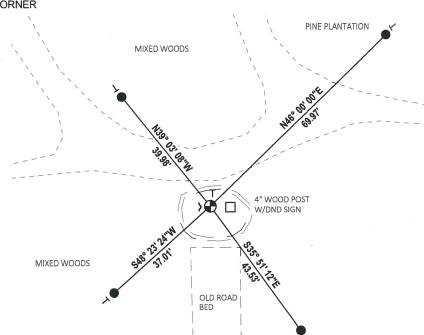

- SET 3/4" x 18" IRON REBAR, 1.50#/FT
- FOUND HARRISON MONUMENT
- STEEL FENCE POST
- VINYL "T" POST

### CORNER NO. ADAMS COUNTY 21 SECTION Survey Monument Record 16 N TOWN TYPE OF MONUMENT: Harrison Monument 7 E **RANGE** STATE PLANE COORDINATES: N. ELEVATION - M.S.L. DATUM: \_ THETA ANGLE: \_ FIELD BOOK: \_\_\_\_ \_ PAGE \_ BASIS FOR MONUMENT LOCATION (Use reverse side if necessary) Show info such as: History of corner, with reference to Vol. and pg, dates, surveyor; exact description of monument replaced; if location computed, by taped or EDM traverse; landowner Ran EDM/I2 Traverse from Northeast corner of Section 21 to the Southeast corner of Section 21 in search of the East Quarter corner. Found no evidence of the original corner within the search area, but did find remonumentation in the form of a 3/4" by 24" iron bar, which fit the possession well. Remonumented the bar found with a Harrison Monument. CORNER 6R-55 CERTIFIED CORRECT O.K. 2-22-77 4-13-82 KZ-6R It 12-26-91 Registered Land Surveyor DATE: April 5, 1976 THES JOK ATTACHED 3-6-02 - JG 10 01-07-JC (Show at least four ties) OK 01-25-12 MS 12"Twin BUR OAK TE PLACED PILE AROUND HARRISON MONUMENT. 28'3 181065 METAL POST BLK OAK/BT/OND SIGN FACES WEST Q SOUTH OF COPINE 9 0,

REVISED 1974

 $\hat{O}$