# OT RANGE ADAMS COUNTY COUNTY CORNER NO: 79

ROMPORTOL ID: 41607232000

## PUBLIC LAND SURVEY MONUMENT RECORD


**HARRISON** TYPE OF MONUMENT: ADAMS COUNTY COORDINATES, NAD 83 (2007) N. 178001.602 E. 583852.955 ELEVATION- - - DATUM\_ 09/30/2020 FIELD WORK DATE:

#### BASIS FOR MONUMENT LOCATION


1978 - PLS 606 THE E1/2 CORNER IS SET ON A STRAIGHT LINE AND HALF WAY BETWEEN THE SE CORNER THEREOF AND NE CORNER THEREOF, BEING HARRISON MONUMENTS FOUND IN PLACE.

UNKNOWN - PLS 878 AREA EXCAVATED WITH BACKHOE, FOUND NOTHING.

2020 - PLS 2675 FOUND HARRISON 4"± BELOW THE GROUND AND 2 WITNESSES. THE MONUMENT AGREES WITH THE TWO WITNESSES. ACCEPTED THE HARRISON AS THE CORNER LOCATION. SET 4 NEW TIES AND MEASURED TO THE EXISTING WITNESSES.

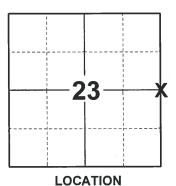

(INDICATE CORNER BY "X")

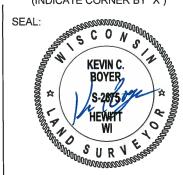


DATA SHOWN HERE ON THIS TIE SHEET IS CORRECT AND COMPLETE TO THE BEST OF MY KNOWLEDGE AND BELIEF.

PROFESSIONAL LAND SURVEYOR

#### -TIE SKETCH

NOTE: THE CORNER LANDS 23.7'± EAST OF 2ND AVE. CENTERLINE.



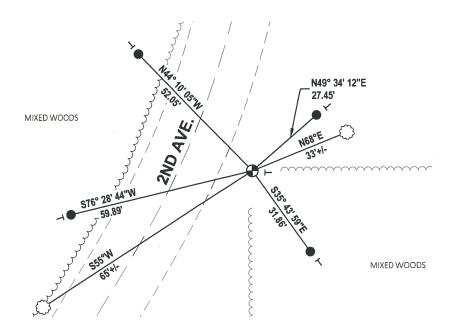

SET 3/4" x 18" IRON REBAR, 1.50#/FT

FOUND HARRISON MONUMENT

VINYL "T" POST

WITNESS TREE

## ADAMS COUNTY

## Survey Monument Record

HARRISON TYPE OF MONUMENT: \_\_\_

STATE PLANE COORDINATES: N.

ELEVATION - M.S.L. DATUM: .

THETA ANGLE: \_

FIELD BOOK: \_\_\_\_ \_\_ PAGE .

### BASIS FOR MONUMENT LOCATION


(Use reverse side if necessary)

Show info such as: History of corner, with reference to Vol. and pg, dates, surveyor; exact description of monument replaced; if location computed, by taped or EDM traverse; landowner remarks, etc.


The Et corner is set on a straight line and half way between the SE corner thereof and the NE corner thereof, being Harrison monuments found in place.

Area Excavated with Backholi by A. Kiedrowski-Foundnothing,

62-55 OK 4-20-82 6K 12-12-86 SK KZ-55 12-23-91 OK 1-15-97 36-55 OK 1-03-02 5-15-07 J6 01-25-12 MS

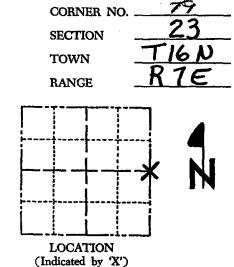

SEAL:

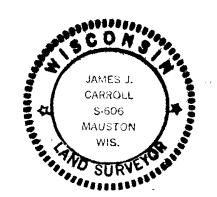

#### TIE SKETCH

(Show at least four ties)

