

24 SECTION 16 TOWN 07 RANGE

ADAMS COUNTY

COUNTY CORNER NO: 80
ROMPORTOL ID: 41607242000

PUBLIC LAND SURVEY MONUMENT RECORD

TYPE OF MONUMENT: HARRISON
ADAMS COUNTY COORDINATES, NAD 83 (2007)

N. 178016.486

E. 589147.125


ELEVATION- DATUM

FIELD WORK DATE: 1/16/2017

BASIS FOR MONUMENT LOCATION

1979 - PLS 878 FOUND NO RECORD OF RESURVEYS. EXCAVATED WITH A BACKHOE AND FOUND A 5 INCH BY 6 INCH BY 11 INCH UPRIGHT BLUE GRANITE STONE WHAT WAS DUG IN AND DOWN 15 INCHES. LOWERED THE STONE AND SET A HARRISON ON TOP. LOCATION VERIFIED BY TRAVERSE OF SECTION 24.

2017 - PLS 2994 FOUND EXISTING HARRISON 3 INCHES BELOW THE ROAD SURFACE AND NO EXISTING WITNESSES. ACCEPTED THE HARRISON AND SET 4 NEW TIES.

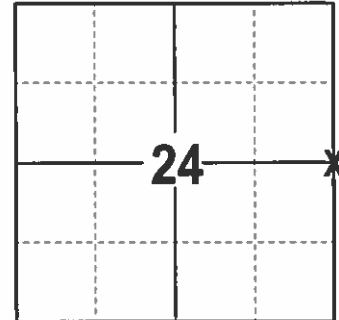

LOCATION
(INDICATE CORNER BY "X")

SEAL:





DATA SHOWN HERE ON THIS TIE SHEET IS CORRECT AND COMPLETE TO THE BEST OF MY KNOWLEDGE AND BELIEF.

PROFESSIONAL LAND SURVEYOR

DATE 3/7/17

- TIE SKETCH

NOTE: THE CORNER FALLS 5' EAST OF THE CENTERLINE OF 1ST AVE.

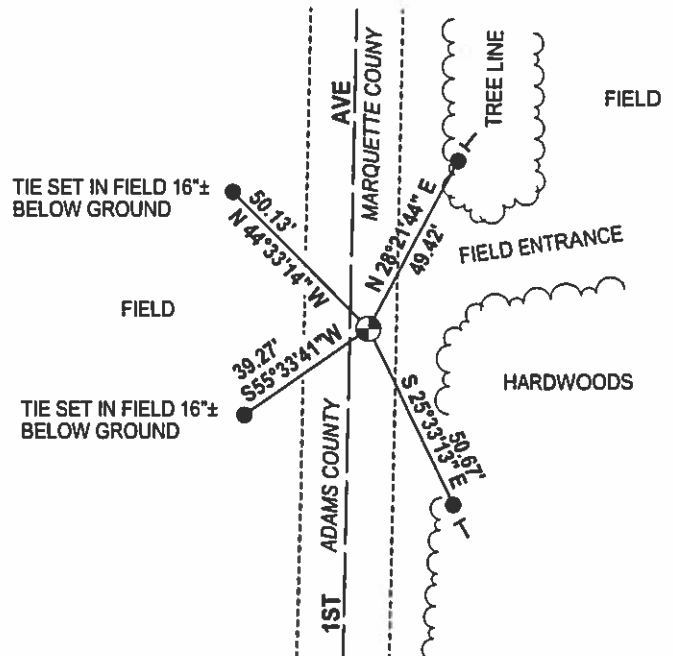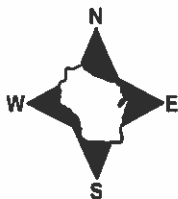


- 3/4" x 18" IRON REBAR SET, 1.50#/FT
- ⊕ FOUND HARRISON
- VINYL "T" POST

Government Land Corner Certificate

ADAMS County
 TYPE OF MONUMENT: HARRISON
 STATE PLANE COORDINATES: N _____
 E _____
 ELEVATION — M.S.L. DATUM: _____
 THETA ANGLE: _____
 FIELD BOOK: 57 (102) PAGE 96 (7)
 DRAWN BY: B.S.

CORNER NO. 80
 SECTION 24
 TOWN 16
 RANGE 7

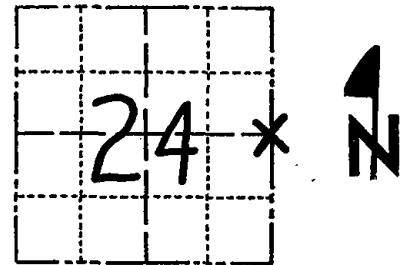

LOCATION
(Indicated by 'X')

BASIS FOR MONUMENT LOCATION

Show info such as: History of corner, with reference to Vol. and pg., dates, surveyor; exact description of monument replaced; if location computed, by taped or EDM traverse; landowner remarks, etc. (Use reverse side if necessary)

No record of resurveys. Excavated with backhoe. Found 5 x 6 x 11" upright blue granite stone definitely dug in, down 15". Lowered stone and set Harrison on top. Location verified by EDM traverse of section 24.

SEAL:




DATA SHOWN HERE ON
CERTIFIED CORRECT:

Anthony B. Kiedrowski
Registered Land Surveyor

DATE: 5/10/79

TIE SKETCH

Show at least four ties, also fence lines, roads, topo, size and type of witness trees' and if off road - best way to arrive at corner.

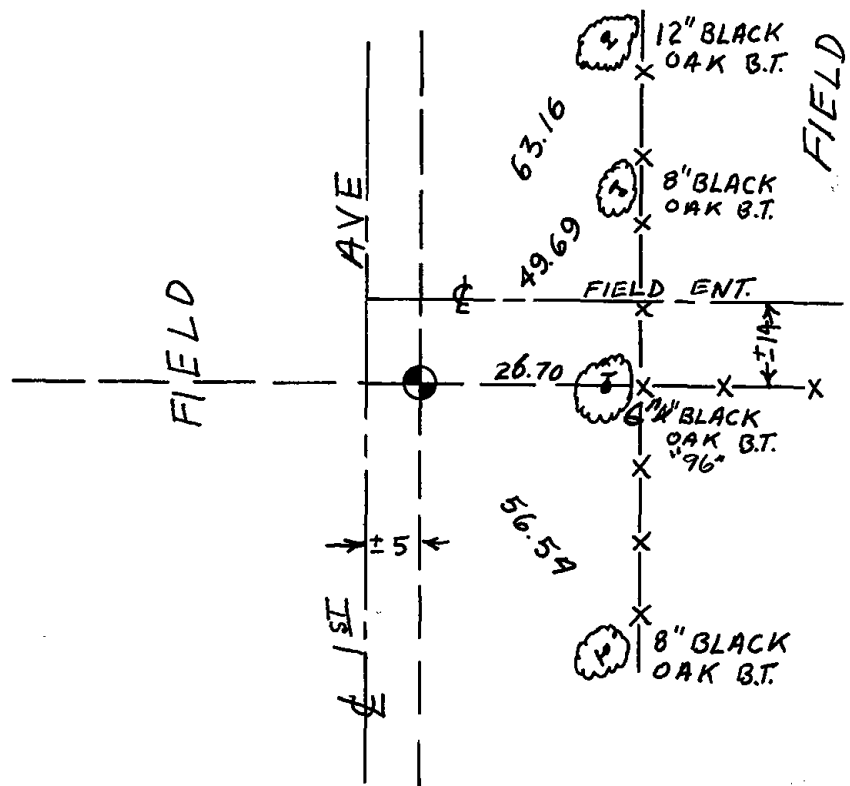

MAINTENANCE RECORD

Date	Init.	Remarks
3-22-82	GRSS	O.K.
12-12-86	CR	OK
12-23-91	KZ-SS	"
12-11-96	Jo-SS	I-GONE, I-NEW
1-03-02	ML	OK
5-15-07	JG	OK
01-23-12	MS	OK