OT RANGE ADAMS COUNTY COUNTY CORNER NO: 87 ROMPORTOL ID: 41607210000

PUBLIC LAND SURVEY MONUMENT RECORD

HARRISON (BROKEN-TOP) TYPE OF MONUMENT: ADAMS COUNTY COORDINATES, NAD 83 (2007)

N. 175363.333

E. 573322.468

DATUM______ **ELEVATION-**

10/01/2020 FIELD WORK DATE:

BASIS FOR MONUMENT LOCATION

1975 - PLS 1103 RAN EDM/TRANSIT TRAVERSE AROUND SECTIONS 27 AND 34, AND PARTS OF SECTION 26 AND 35. ESTABLISHED LOCATION OF CORNER BY RECONSTRUCTION OF SURVEY BY FRED ZIETLOW, RLS 922, IN SECTION 28.

2020 - PLS 2675 FOUND HARRISON (BROKEN-TOP) 6"± BELOW THE GROUND AND 1 WITNESS. THE MONUMENT AGREES WITH THE WITNESS (SLOPE DISTANCE). ACCEPTED THE HARRISON (BROKEN-TOP) AS THE CORNER LOCATION. SET 4 NEW TIES AND MEASURED TO THE EXISTING WITNESS.



(INDICATE CORNER BY "X")




DATA SHOWN HERE ON THIS TIE SHEET IS CORRECT AND COMPLETE TO THE BEST OF MY KNOWLEDGE AND BELIEF.

PROFESSIONAL LAND SURVEYOR

-TIE SKETCH

NOTE: THE CORNER LANDS 28'± NORTH OF EMBER AVE. CENTERLINE.



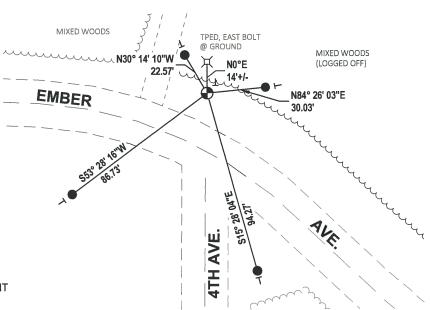

- SET 3/4" x 18" IRON REBAR, 1.50#/FT
- FOUND HARRISON (BROKEN-TOP) MONUMENT
- VINYL "T" POST


ADAMS COUNTY

Survey Monument Record

TYPE OF MONUMENT: Harrison Standard STATE PLANE COORDINATES: N_ ELEVATION — M.S.L. DATUM: ___

THETA ANGLE: __

FIELD BOOK: ______ PAGE _

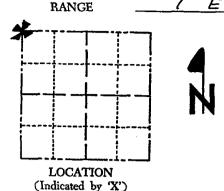

CORNER NO.

SECTION

TOWN

SEAL:

673

BASIS FOR MONUMENT LOCATION

(Use reverse side if necessary)

Show info such as: History of corner, with reference to Vol. and pg, dates, surveyor; exact description of monument replaced; if location computed, by taped or EDM traverse; landowner remarks, etc.

Ran EDM/transit traverse around Sections 27 and 34. and parts of Section 26 and 35.

Established location of corner by re-construction of survey by Fred Zietlow, RLS 922, in Section 28.

Wisconsin Rapids,

CORNER 3-31-77 O.K. GR-SS 3-22-82 12-9-86 12-26-91 KZ-GR 12-6-96 12-28-01 - ML

CERTIFIED CORRECT DATE:

6-11-07 - 56 TIE SKETCH 01-18-12 (Show at least four ties) (DEMO) GONE BOUT-EAST SIDE HTEZ. JET. BOX 5"Black Oak 67.68 84.12, 12" Black Gal BIBLACK DAFFE