

23
SECTION

16
TOWN

07
RANGE

ADAMS COUNTY

COUNTY CORNER NO: 90

ROMPORTOL ID: 41607230020

PUBLIC LAND SURVEY MONUMENT RECORD

TYPE OF MONUMENT: HARRISON
ADAMS COUNTY COORDINATES, NAD 83 (2007)

N. 175358.273

E. 581203.355


ELEVATION- _____ DATUM _____

FIELD WORK DATE: 09/30/2020

BASIS FOR MONUMENT LOCATION


1976 - PLS 922 CHECKED ADAMS COUNTY SURVEY RECORDS AND NO RESURVEYS WERE ON FILE MAKING REFERENCE TO THIS CORNER. RAN EDM TRAVERSE OF ENTIRE SECTION AND RE-ESTABLISHED THIS CORNER BY THE SINGLE PROPORTIONATE METHOD.

2020 - PLS 2675 FOUND HARRISON 6"± BELOW THE ROAD SURFACE AND 2 WITNESSES. THE MONUMENT AGREES WITH BOTH WITNESSES. ACCEPTED THE HARRISON AS THE CORNER LOCATION. SET 4 NEW TIES AND MEASURED TO THE EXISTING WITNESSES.

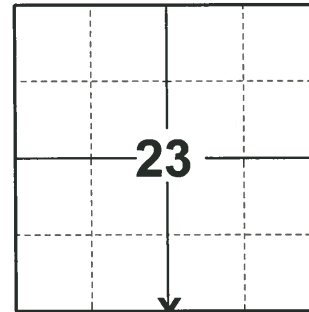

LOCATION
(INDICATE CORNER BY "X")

SEAL:

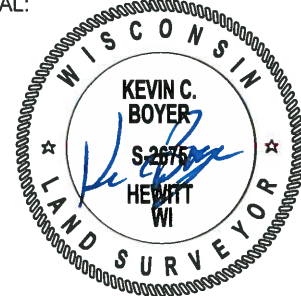


DATA SHOWN HERE ON THIS TIE SHEET IS CORRECT AND COMPLETE TO THE BEST OF MY KNOWLEDGE AND BELIEF.

PROFESSIONAL LAND SURVEYOR

DATE 11/3/2020

TIE SKETCH

NOTE: THE CORNER LANDS 7.3'± NORTH OF EMBER AVE. CENTERLINE AND 24.8'± WEST OF 2ND DR. CENTERLINE.

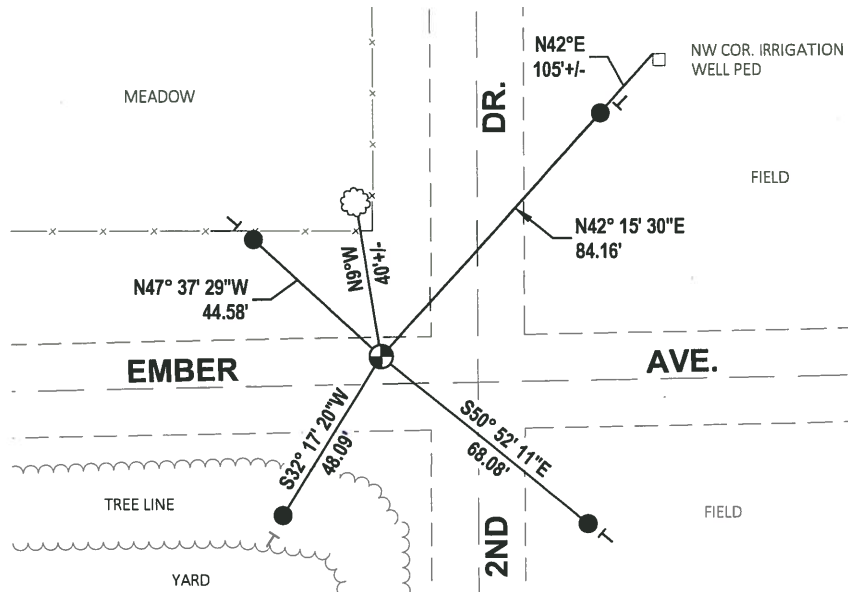

- SET 3/4" x 18" IRON REBAR, 1.50#/FT
- ⊕ FOUND HARRISON MONUMENT
- ┊ VINYL "T" POST
- ☼ WITNESS TREE

ADAMS COUNTY

Survey Monument Record

TYPE OF MONUMENT: STANDARD 30" HARRISON

STATE PLANE COORDINATES: N _____
E _____

ELEVATION — M.S.L. DATUM: _____

THETA ANGLE: _____


FIELD BOOK: _____ PAGE _____

CORNER NO. 1063 ⁹⁰

SECTION 26

TOWN 16N

RANGE 7E

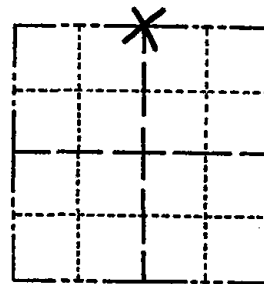

LOCATION
(Indicated by 'X')

SEAL:



BASIS FOR MONUMENT LOCATION

(Use reverse side if necessary)

Show info such as: History of corner, with reference to Vol. and pg. dates, surveyor; exact description of monument replaced; if location computed, by taped or EDM traverse; landowner remarks, etc.

CHECKED ADAMS COUNTY SURVEY RECORDS AND NO RESURVEYS WERE ON FILE MAKING REFERENCE TO THIS CORNER. RAN EDM. TRAVERSE OF ENTIRE SECTION & RE-ESTABLISHED THIS CORNER BY THE SINGLE PROPORTIONATE METHOD

CORNER	O.K.	3-28-77	GR 55
"	"	3-22-82	"
"	"	12-9-86	"
"	"	11-25-91	62- 82
"	"	12-6-96	SS
"	"	1-09-02	MH
"	"	5-15-07	JG

CERTIFIED CORRECT:

Frederic W. Zietlow
Registered Land Surveyor

DATE: SEPTEMBER 30, 1976

TIE SKETCH OK 01-18-12 MS

(Show at least four ties)

