OT RANGE ADAMS COUNTY COUNTY CORNER NO: 92

ROMPORTOL ID: 41607240020

PUBLIC LAND SURVEY MONUMENT RECORD

HARRISON TYPE OF MONUMENT: ADAMS COUNTY COORDINATES, NAD 83 (2007) N. 175378.698

ELEVATION- - - DATUM


09/30/2020 FIELD WORK DATE:

E 586456.926

BASIS FOR MONUMENT LOCATION

1976 - PS 1478 SET MONUMENT EQUIDISTANT AND ON LINE BETWEEN ADJACENT SECTION CORNERS. NO EVIDENCE OF THE CORNER NOR THE B.T. BY M.C. SMITH (VOL. 1 PG. 87) WERE FOUND DURING EXCAVATION WITH BACKHOE AT THIS POINT.

2020 - PLS 2675 FOUND HARRISON 3"± BELOW THE ROAD SURFACE AND 2 WITNESSES. THE MONUMENT AGREES WITH BOTH WITNESSES, ACCEPTED THE HARRISON AS THE CORNER LOCATION. SET 4 NEW TIES AND MEASURED TO THE EXISTING WITNESSES.

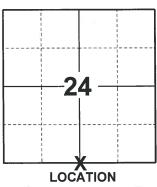

(INDICATE CORNER BY "X")




DATA SHOWN HERE ON THIS TIE SHEET IS CORRECT AND COMPLETE TO THE BEST OF MY KNOWLEDGE AND BELIEF.

PROFESSIONAL LAND SURVEYOR

-TIE SKETCH

NOTE: THE CORNER LANDS 3.3'± NORTH OF EMBER AVE. CENTERLINE.



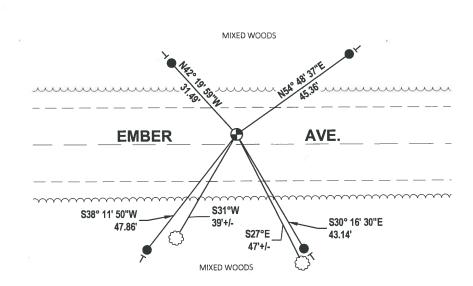

SET 3/4" x 18" IRON REBAR, 1.50#/FT

FOUND HARRISON MONUMENT

VINYL "T" POST

WITNESS TREE

CORNER NO. 92 Adams County TYPE OF MONUMENT: Havyisan STATE PLANE COORDINATES: N E ELEVATION — M.S.L. DATUM: THETA ANGLE: FIELD BOOK: PAGE DRAWN BY: NJ. BASIS FOR MONUMENT LOCATION			
TYPE OF MONUMENT: Havyisan TOWN 16 STATE PLANE COORDINATES: N			
STATE PLANE COORDINATES: N			
E RANGE ELEVATION — M.S.L. DATUM: THETA ANGLE: FIELD BOOK: DRAWN BY: PAGE 7 1			
THETA ANGLE: FIELD BOOK: PAGE DRAWN BY:			
FIELD BOOK: PAGE PAGE PAGE PAGE			
DRAWN BY: N.J.			
BASIS FOR MONUMENT LOCATION			
Show info such as: History of corner, with reference to Vol.			
and pg., dates, surveyor; exact description of monument replaced; if location computed, by taped or EDM traverse; landowner remarks, etc. (Use reverse side if necessary) LOCATION (Indicated by X')			
landowner remarks, etc. (Use reverse side if necessary) (Indicated by 'X') SEAL:			
Set manufact and an line between the set of			
Set monument equidistant and on line between adjacent section corners.			
Set monument equidistant and on line between adjacent section corners. No evidence of the corner nor the B. T. by M. C. Smith (Vol. 1 pg 87) were found during excavation with backhoe at this point. GREGORY P. RHINEHART S.1478 Wisconsin Rapids			
No evidence of the corner nor the B. T. by M. C. Smith (Vol. 1 pg 87) were found during excavation Shidts (Shidts)			
with backhoe at this point. Wisconsin Rapids Wisconsin Rapids			
AND SURVE			
07/1/18/11/18/08/08/08/0			
Set monument equidistant and on line between adjacent section corners. No evidence of the corner nor the B. T. by M. C. Smith (Vol. 1 pg 87) were found during excavation with backhoe at this point. SEAL: (Indicated by 'X') SEAL: (Indicated by 'X') SEAL: ONS MINIMAL CONSTITUTE ON SEAL: DATA SHOWN HERE ON			
CERTIFIED CORRECT:			
Registered Land Surveyor			
0,0/_/_a			
DATE:			
TIE SKETCH PINE			
Show at least four ties also fence lines roads tono size OI ANTATIMAL			
and type of witness trees and if off road - best way to "DEAD of" 12" PINE 8"W. PINE/BT arrive at corner. DEAD OF" 14'BIK			
4"CEDAR 3 CAK BT OAK BT 12" BIK OAK BT-STUMB			
57.60. 30.35 W			
S P. K. & RIBBON			
S'S P.K. & RIBBON. NOT KEI.'S			
Q EMBER AUE			
20°BIK NO TOUT 8"W. P. NE/BT			
OAK BY SEN			
NEW DISTANCE)			

MAINTENANCE RECORD

DATE	BY WHOM	REMARKS
3-22-82	Rhinehart - Sorenson	ALC O.K.
6-28-85	DAN PAULSON	OK
12-9-86	RHINEHART SCRENSEL!	//
12-23-71	rz-ss	<i>I</i> *
12-11-96	56-35	ALL OK
1-09-02	ML	OK .
5-15-07	JG	3- CONE 4-NEW MON. OK
01-18-12	MS	I NEW TIE