# OT ADAMS COUNTY COUNTY CORNER NO: 96

ROMPORTOL ID: 41607292000

## PUBLIC LAND SURVEY MONUMENT RECORD

**HARRISON** TYPE OF MONUMENT: ADAMS COUNTY COORDINATES, NAD 83 (2007)

N. 172624.197

E. 568023.428

- — — DATUM\_\_ ELEVATION-


08/26/2020 FIELD WORK DATE:

#### BASIS FOR MONUMENT LOCATION

1979 - PLS 1478 SET MONUMENT EQUIDISTANT AND ON LINE BETWEEN ADJACENT SECTION CORNERS. NO RECORDS OF ANY MONUMENTATION SUBSEQUENT TO THE ORIGINAL WAS FOUND. NO EVIDENCE OF ANY PREVIOUS MONUMENTATION WAS FOUND.

2020 - PLS 2675 FOUND HARRISON 2"± ABOVE THE GROUND AND 3 WITNESS TREES. THE MONUMENT AGREES WITH ALL 3 WITNESS TREES. ACCEPTED THE HARRISON AS THE CORNER LOCATION. SET 4 NEW TIES AND MEASURED TO THE EXISTING WITNESS TREES.

\*BEST ACCESS IS TO COME OFF OF EMBER DR. AND STOP BY LANDOWNER FOR HIS PERMISSION.\*

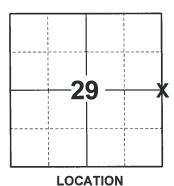

(INDICATE CORNER BY "X")



DATA SHOWN HERE ON THIS TIE SHEET IS CORRECT AND COMPLETE TO THE BEST OF MY KNOWLEDGE AND BELIEF.

PROFESSIONAL LAND SURVEYOR

DATE


### -TIE SKETCH

NOTE: THE CORNER LANDS 300'± SOUTH OF A WOODS TRAIL.



SET 3/4" x 18" IRON REBAR, 1.50#/FT FOUND HARRISON MONUMENT

- STEEL FENCE POST
- VINYL "T" POST
- WITNESS TREE

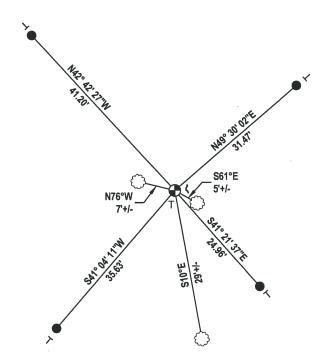

Government Land Corner Certificate		61
Adams County	CORNER NO	96
TYPE OF MONUMENT: Harrison	SECTION .	29
STATE PLANE COORDINATES: N	TOWN	16
<u>E</u>	RANGE .	
ELEVATION — M.S.L. DATUM:	<del></del>	٦
THETA ANGLE: PAGE		
DRAWN BY: N.J.	70	j <b>7</b> .
	=   T+7	* N
BASIS FOR MONUMENT LOCATION		
Show info such as: History of corner, with reference to Vol.		j
and pg., dates, surveyor; exact description of monument replaced; if location computed, by taped or EDM traverse; landowner remarks, etc. (Use reverse side if necessary)	LOCATION	······································
	SEAL: (Indicated by 'X')	
Set monument equidistant and on line between adjace	ent	<b>*</b>
section corners.	HINNIECONS !!!	T. A. A.
No records of any monumentation subsequent to the	GREGORY P. RHINEHART S-1478 Wisconsin Rapids Wis.  DATA SHOWN HERE ON	
original was found.	GREGORY P. RHINEHART	7
No evidence of any previous monumnetation was found	S-1478 Wisconsin Rapids	
	Wis.	1986
	The state of the s	, si
	AND SURVE	6
	DATA SHOWN HERE ON	
	CERTIFIED CORRECT:	
	Sugary P Rhe	rehard
	Registered Land Surveyor	100
	DATE:	//9
TIE SKETCH TRAIL		
	OAK /BT	
and type of witness trees and if off road - best way to	βr /βr	
arrive at corner.		
↑	<i>(</i> , , , , , , , , , , , , , , , , , , ,	
8"Bik OAK	10" BLK OAK	
FACES NORTH (2)	o'	
PACES NOTTH (5) ?.39. 05.	85 30" WHITE 120 ± E	
1 5.0'	1 OAK 12 F	TO ENCE
STEEL FENCE		
POST NORTH OF CORNER	3	
OF CORNER TO	35.	
1	<i>~</i>	
	10" BIK OAK/BT	
	, =	
7*31	K OAK/BT	

## MAINTENANCE RECORD

DATE	BY WHOM	REMARKS
4-13-82	Rhinehart - Sorenson	DRIVE IN OPP. V. HERRELL'S FARM ON ENDER
11-19-86	11 11	OK.
1-5-92	GR-56	OK
4-2-97	JC-S5	ØK .
3-4-02	Ja	OK.
6-19-07	16	0K
01-25-12	ms	I NEW TIE
-		