OT RANGE ADAMS COUNTY COUNTY CORNER NO: 97

ROMPORTOL ID: 41607282000


PUBLIC LAND SURVEY MONUMENT RECORD

HARRISON TYPE OF MONUMENT: ADAMS COUNTY COORDINATES, NAD 83 (2007) N. **172699.411** E. 573305.847 ELEVATION- - - DATUM_ 10/06/2020 FIELD WORK DATE:

BASIS FOR MONUMENT LOCATION

1975 - PLS 1103 RAN EDM/TRANSIT TRAVERSE AROUND SECTIONS 27 AND 34; AND PARTS OF SECTIONS 26 AND 35. ESTABLISHED LOCATION OF CORNER BY RE-CONSTRUCTION OF SURVEY BY FRED ZIETLOW, RLS 922, IN SECTION 28. DID NOT ATTEMPT TO EXCAVATE BECAUSE CORNER FALLS IN CUT SECTION OF ROAD.

2020 - PLS:2675 FOUND HARRISON FLUSH WITH THE ROAD SURFACE, 1 TIE AND 2 WITNESSES. THE MONUMENT AGREES WITH THE EXISTING TIE AND WITNESSES. ACCEPTED THE HARRISON AS THE CORNER LOCATION. SET 1 NEW TIE, MEASURED TO FOUND PROPERTY IRONS, AND THE EXISTING TIE AND WITNESSES.

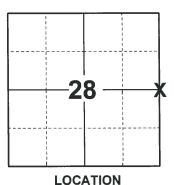

(INDICATE CORNER BY "X")



DATA SHOWN HERE ON THIS TIE SHEET IS CORRECT AND COMPLETE TO THE BEST OF MY KNOWLEDGE AND BELIEF.


PROFESSIONAL LAND SURVEYOR

2070

-TIE SKETCH

AVE. CENTERLINE.

- SET 3/4" x 18" IRON REBAR, 1.50#/FT
- FOUND 3/4" IRON ROD FOUND HARRISON MONUMENT
- STEEL FENCE POST
- VINYL "T" POST
- WITNESS TREE

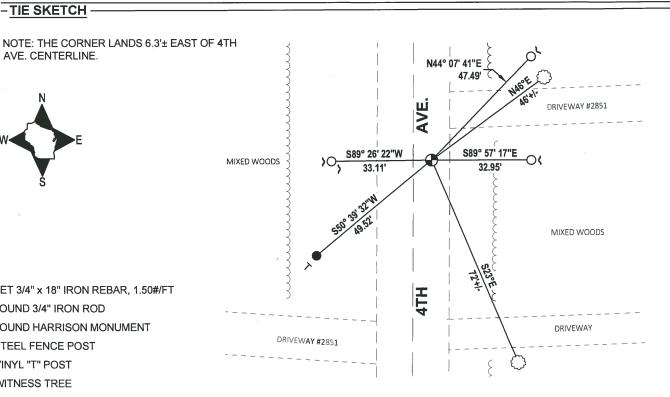

ADAMS COUNTY

Survey Monument Record

TYPE OF MONUMENT: Standard Harrison


STATE PLANE COORDINATES: N_____

E_____

ELEVATION — M.S.L. DATUM:

THETA ANGLE:

FIELD BOOK: PAGE

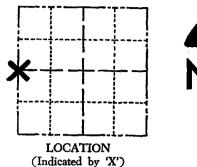

CORNER NO. <u>685</u>

16

SECTION

TOWN

RANGE

BASIS FOR MONUMENT LOCATION


(Use reverse side if necessary)

Show info such as: History of corner, with reference to Vol. and pg, dates, surveyor; exact description of monument replaced; if location computed, by taped or EDM traverse; landowner remarks, etc.

Ran EDM/transit traverse around Sections 27 and 34; and parts of Sections 26 and 35.

Established location of corner by re-construction of survey by Fred Zietlow, RLS 922, in Section 28.

Did not attempt to excavate because corner falls in cut section of road.

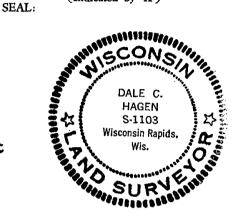


GR-55 4-12-82 COR. OK GR 10 12-17-86 12-26-91 KZ-6R 160NE - INEW 12-16-96 55 OK 3-4-02 JG ok 6-19-07 OK

01-20-12

Registered Land Surveyor
DATE: 4/3/75

TIE SKETCH

(Show at least four ties)

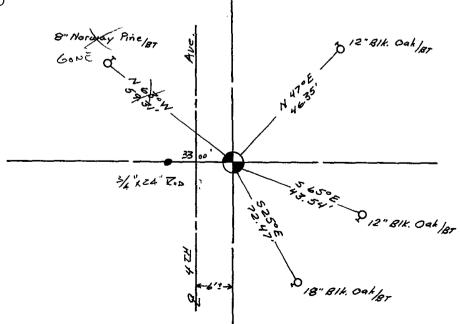

ADAMS COUNTY

Survey Monument Record

TYPE OF MONUMENT: Standard Harrison


STATE PLANE COORDINATES: N.

F.

ELEVATION - M.S.L. DATUM: _

THETA ANGLE: _

_ PAGE _ FIELD BOOK: ____

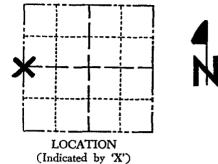

CORNER NO. <u>68</u>5

16

SECTION

TOWN

RANGE

SEAL:

BASIS FOR MONUMENT LOCATION

(Use reverse side if necessary)


Show info such as: History of corner, with reference to Vol. and pg, dates, surveyor; exact description of monument replaced; if location computed, by taped or EDM traverse; landowner

Ran EDM/transit traverse around Sections 27 and 34; and parts of Sections 26 and 35.

Established location of corner by re-construction of survey by Fred Zietlow, RLS 922, in Section 28.

Did not attempt to excavate because corner falls in cut section of road.



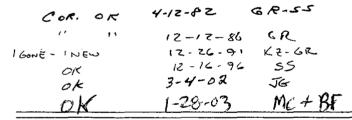

TIE SKETCH

(Show at least four ties)

