

PUBLIC LAND SURVEY MONUMENT RECORD

TYPE OF MONUMENT: SET 3/4" X 18" IRON REBAR, 1.50#/FT
ADAMS COUNTY COORDINATES, NAD 83 (2007)

N. 169997.756

E. 560086.110


ELEVATION- DATUM

FIELD WORK DATE: 10/07/2020

BASIS FOR MONUMENT LOCATION

1972 - PLS 981 FOUND CONCRETE MONUMENT STAMPED "N1/4 SEC 31"

2020 - PLS 2675 FOUND NO EVIDENCE OF THE CORNER DUG A 3'X4' HOLE AS SEARCH AREA. DID FIND 1 WITNESS AND 1 TIE AND A PROPERTY IRON FROM CSM #3849 VOL. 17 PG. 201-202 RECORDED 02/03/99. CALCULATED CORNER POSITION WITH A DISTANCE DISTANCE INTERSECTION FROM THE SW CORNER OF SECTION 30 AND THE FOUND PROPERTY IRON FROM SAID CSM. THIS LOCATION AGREES WITH BOTH THE TIE DISTANCE TO THE SOUTH AND WITNESS DISTANCE TO THE SE. SET A 3/4" X 18" IRON REBAR, 1.50#/FT AT THE CORNER LOCATION, 3 NEW TIES AND MEASURED TO THE EXISTING TIE AND WITNESS.

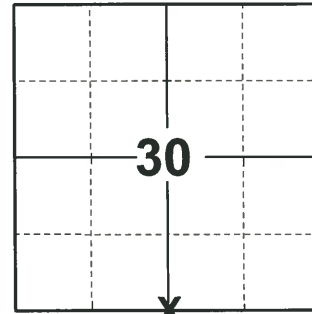

LOCATION
(INDICATE CORNER BY "X")

SEAL:



DATA SHOWN HERE ON THIS TIE SHEET IS CORRECT AND COMPLETE TO THE BEST OF MY KNOWLEDGE AND BELIEF.

PROFESSIONAL LAND SURVEYOR

DATE 11/3/2020

- TIE SKETCH

NOTE: THE CORNER LANDS 25'± NORTH OF CTH 'A' CENTERLINE.

