16

OT RANGE ADAMS COUNTY CORNER NO: 103 ROMPORTOL ID: 41607300000

PUBLIC LAND SURVEY MONUMENT RECORD

HARRISON (BROKEN-TOP) TYPE OF MONUMENT: ADAMS COUNTY COORDINATES, NAD 83 (2007)

N. **170002.159**

E. 562731.777


ELEVATION- - - DATUM - -

10/06/2020 FIELD WORK DATE:_

BASIS FOR MONUMENT LOCATION

1974 - PLS 878 THIS POINT SET BY INTERSECTING THE NORTH LINE OF THE NORTHWEST 1/4 OF THIS SECTION EXTENDING TO A LINE 33' EAST OF WHISPERING OAKS SUB.

2020 - PLS 2675 FOUND HARRISON (BROKEN-TOP) 18"± BELOW THE ROAD SURFACE AND DID NOT RECOVER ANY EXISTING TIES OR WITNESSES. ACCEPTED THE HARRISON (BROKEN-TOP) AS THE BEST AVAILABLE EVIDENCE OF THE CORNER LOCATION AND SET 4 NEW TIES.

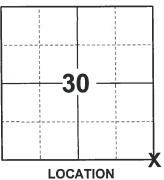

(INDICATE CORNER BY "X")



DATA SHOWN HERE ON THIS TIE SHEET IS CORRECT AND COMPLETE TO THE BEST OF MY KNOWLEDGE AND BELIEF.


PROFESSIONAL LAND SURVEYOR

7020

-TIE SKETCH

NOTE: THE CORNER LANDS 1.7'± EAST OF 6TH AVE. CENTERLINE AND 24.6'± NORTH OF CTH 'A' CENTERLINE.



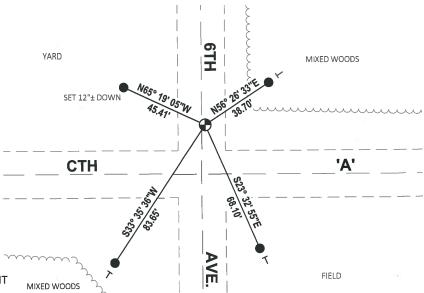

SET 3/4" x 18" IRON REBAR, 1.50#/FT

FOUND HARRISON (BROKEN-TOP) MONUMENT

VINYL "T" POST

ADAMS COUNTY

Survey Monument Record

TYPE OF MONUMENT: Harrison Standard STATE PLANE COORDINATES: N____ ELEVATION — M.S.L. DATUM: ____

THETA ANGLE: _

FIELD BOOK: _____ PAGE _____


BASIS FOR MONUMENT LOCATION

(Use reverse side if necessary)

Show info such as: History of corner, with reference to Vol. and pg, dates, surveyor; exact description of monument replaced; if location computed, by taped or EDM traverse; landowner

This point set by intersecting the north line of the northwest 4 of this section extended to a line 33' east of Wix Whispering Oaks Sub.

CORNER 2-22-77 GR-55 O.K. 3.22-82 12-9-36 KZ-GR 12-26-91 1/15/97 1-03-02 - Mh И 16-55 2 NEW TIES 1-30-07 01-20-12 OK

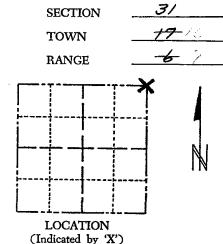

CORNER NO. _

SEAL:



CERTIFIED CORRECT: Registered Land Surveyor DATE: 6/6/74

TIE SKETCH

(Show at least four ties)

QC.T.H. "A

TOP-CENTER GROUND

> Power pole with 50 Penny

Ties are to mail and disc.

REVISED 1972