

28
SECTION

16
TOWN

07
RANGE

ADAMS COUNTY

COUNTY CORNER NO: 106

ROMPORTOL ID: 41607280020

PUBLIC LAND SURVEY MONUMENT RECORD

TYPE OF MONUMENT: HARRISON
ADAMS COUNTY COORDINATES, NAD 83 (2007)

N. 170026.371

E. 570653.792


ELEVATION- DATUM

FIELD WORK DATE: 08/26/2020

BASIS FOR MONUMENT LOCATION


1987 - PLS 878 SET EQUIDISTANT AND ON LINE BETWEEN ADJACENT SECTION CORNERS. A THOROUGH SEARCH OF THE AREA YIELDED NO EVIDENCE OF ANY PREVIOUS MONUMENTATION.

2020 - PLS 2675 FOUND HARRISON 2"± ABOVE THE GROUND AND 3 WITNESS TREES. THE MONUMENT AGREES WITH ALL 3 WITNESS TREES. ACCEPTED THE HARRISON AS THE CORNER LOCATION. SET 4 NEW TIES AND MEASURED TO THE EXISTING WITNESS TREES.

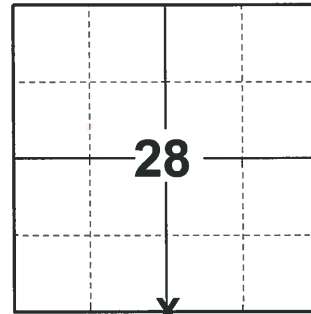

LOCATION
(INDICATE CORNER BY "X")

SEAL:


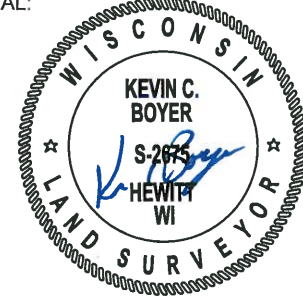


DATA SHOWN HERE ON THIS TIE SHEET IS CORRECT AND COMPLETE TO THE BEST OF MY KNOWLEDGE AND BELIEF.

PROFESSIONAL LAND SURVEYOR

DATE 11/3/2020

- TIE SKETCH

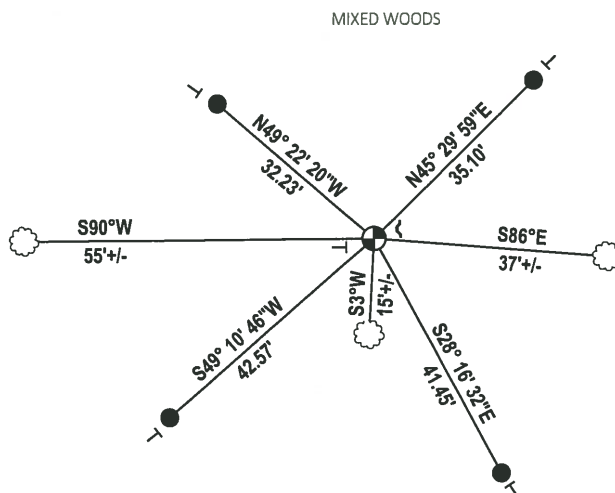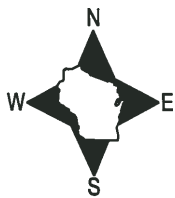

- SET 3/4" x 18" IRON REBAR, 1.50#/FT
- ⊕ FOUND HARRISON MONUMENT
- ✓ STEEL FENCE POST
- VINYL "T" POST
- ☉ WITNESS TREE

Government Land Corner Certificate

ADAMS County

TYPE OF MONUMENT: HARRISON

STATE PLANE COORDINATES: N _____
E _____


ELEVATION — M.S.L. DATUM: _____

THETA ANGLE: _____

FIELD BOOK: 57 PAGE 66

DRAWN BY: B. MERZ

CORNER NO. 106
SECTION 33
TOWN 16
RANGE 7

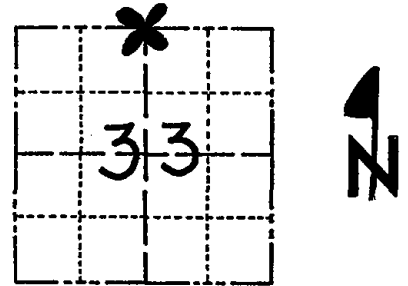

LOCATION
(Indicated by 'X')

BASIS FOR MONUMENT LOCATION

Show info such as: History of corner, with reference to Vol. and pg., dates, surveyor; exact description of monument replaced; if location computed, by taped or EDM traverse; landowner remarks, etc. (Use reverse side if necessary)

Set equidistant and on line between adjacent section corners. A thorough search of the area yielded no evidence of any previous monumentation.

SEAL:




DATA SHOWN HERE ON
CERTIFIED CORRECT:

Anthony B. Kiedrowski
Registered Land Surveyor

DATE: 8-1-78

TIE SKETCH

Show at least four ties, also fence lines, roads, topo, size and type of witness trees' and if off road - best way to arrive at corner.

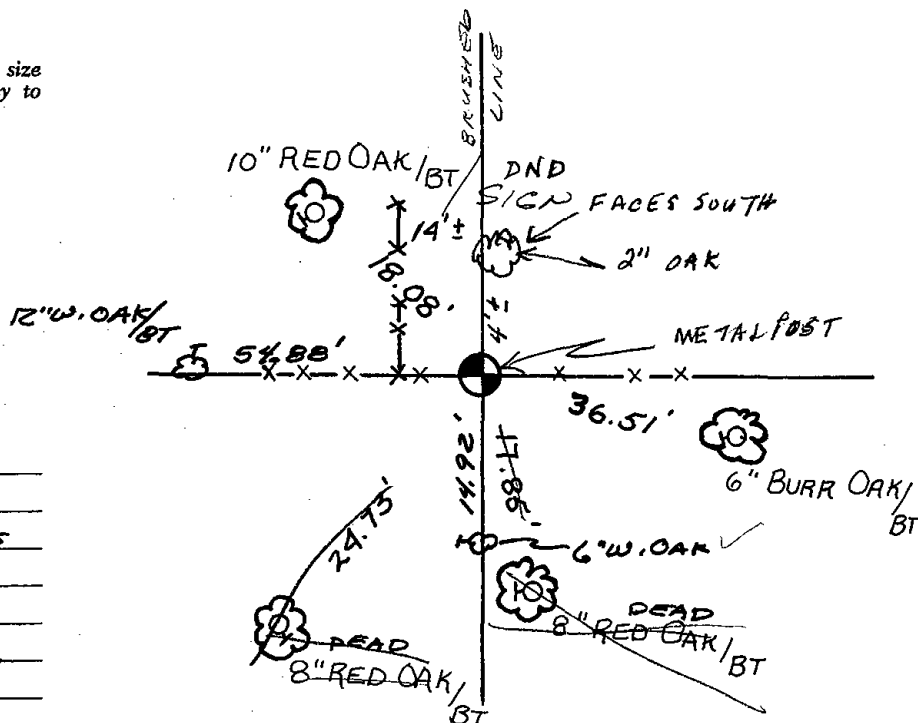

MAINTENANCE RECORD

Date	Init.	Remarks
4-13-82	GR-SS	CoA. OK - NOW TIES
11-19-86	GR-SS	"
1-2-92	GR-JG	"
12-16-96	SS	OK
3-6-02	JG	OK
6-19-07	JG	OK
01-11-12	MS	OK