OT ADAMS COUNTY COUNTY CORNER NO: 109

ROMPORTOL ID: 41607270000

PUBLIC LAND SURVEY MONUMENT RECORD

HARRISON TYPE OF MONUMENT: ADAMS COUNTY COORDINATES, NAD 83 (2007) N. 170048.485 E. 578571.965 _ DATUM__ ELEVATION-_ 08/25/2020 FIELD WORK DATE:

BASIS FOR MONUMENT LOCATION

1975 - PLS 1103 RAN EDM/TRANSIT TRAVERSE AROUND SECTIONS 27 AND 34 AND PARTS OF SECTIONS 26 AND 35. COULD FIND NO EVIDENCE OF THE ORIGINAL CORNER OR ANY REMONUMENTATION. ALL OF THE ADJACENT LAND IS UNDER SINGLE OWNERSHIP AND HAS BEEN CULTIVATED, SO NO ATTEMPT TO EXCAVATE WAS MADE. SET CORNER BY DOUBLE PROPORTIONATE MEASURE BETWEEN ADJACENT GOVERNMENT CORNERS.

2020 - PLS 2675 FOUND HARRISON 4"± BELOW THE GROUND AND 1 WITNESS TREE. THE MONUMENT AGREES WITH THE WITNESS TREE. ACCEPTED THE HARRISON AS THE CORNER LOCATION. SET 4 NEW TIES AND MEASURED TO THE EXISTING WITNESS TREE.



(INDICATE CORNER BY "X")



DATA SHOWN HERE ON THIS TIE SHEET IS CORRECT AND COMPLETE TO THE BEST OF MY KNOWLEDGE AND BELIEF.


PROFESSIONAL LAND SURVEYOR

2070 DATE

-TIE SKETCH



- SET 3/4" x 18" IRON REBAR, 1.50#/FT
- FOUND HARRISON MONUMENT
- STEEL FENCE POST
- VINYL "T" POST
- WITNESS TREE

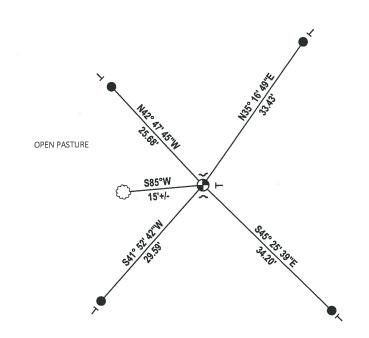

ADAMS COUNTY

Survey Monument Record


TYPE OF MONUMENT: Standard Harrison

STATE PLANE COORDINATES: N.

ELEVATION - M.S.L. DATUM:

THETA ANGLE: _

54 FIELD BOOK: _ **PAGE**

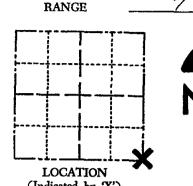

CORNER NO.

SECTION

TOWN

686

BASIS FOR MONUMENT LOCATION

(Use reverse side if necessary)

Show info such as: History of corner, with reference to Vol. and pg, dates, surveyor; exact description of monument replaced; if location computed, by taped or EDM traverse; landowner

Ran EDM/transit traverse around Sections 27 and 34. and parts of Sections 26 and 35.

Could find no evidence of the original corner or any remonumentation. All of the adjacent land is under single ownership and has been cultivated, so no attempt to excavate was made.

Set corner by double proportionate measure between adjacent government corners.

CORNER	0.K.	2-22-77 4-13-82	GR-55 "
4	16	1-5-87	47
H	Û	1-2-92	6R-16
It	IL	1-15-97	J6-55




CERTIFIED CORRECT: Registered Land Surveyor

DATE:

6-3-75

TIE SKETCH CORNER OK 3-5-02 - JG (Show at least four ties) OK 01-25-12 MS

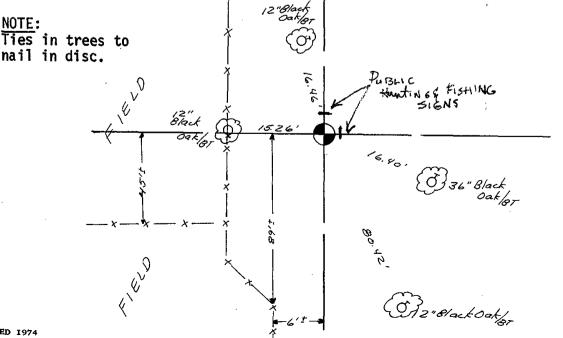

REVISED 1974

NOTE:

