OT ADAMS COUNTY

COUNTY CORNER NO: 128

ROMPORTOL ID: 41607340020

PUBLIC LAND SURVEY MONUMENT RECORD


DWY #2981

TYPE OF MONUMENT: **HARRISON** ADAMS COUNTY COORDINATES, NAD 83 (2007) N. **164753.237** E. <u>575898.304</u> DATUM - ----**ELEVATION-**12/12/2017 FIELD WORK DATE:


BASIS FOR MONUMENT LOCATION

1975 - PLS 1103 RAN EDM/TRANSIT TRAVERSE AROUND SECTIONS 27, 32, 33, 34 AND ADJACENT SECTION CORNERS TO DETERMINE THE SEARCH AREA. DID NOT EXCAVATE BECAUSE THE SEARCH AREA FALLS WITHIN A CULTIVATED FIELD. RE-ESTABLISHED THE CORNER BY SINGLE PROPORTIONATE MEASUREMENT ON A LINE BETWEEN THE ADJACENT SECTION CORNERS, SET A HARRISON MONUMENT AT THE CALCULATED LOCATION AND TIED OUT.

2017 - PLS 2994 FOUND A HARRISON MONUMENT 18" BELOW THE SURFACE OF THE FIELD. DID NOT RECOVER ANY TIES OR WITNESSES. ACCEPTED THE HARRISON MONUMENT AS THE CORNER LOCATION, SET 4 NEW TIES AND MEASURED TO THE TIES.

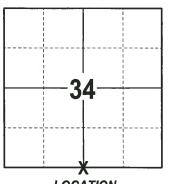

LOCATION (INDICATE CORNER BY "X")

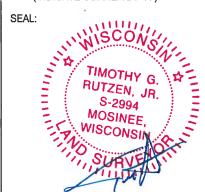

DATA SHOWN HERE ON THIS TIE SHEET IS CORRECT AND COMPLETE TO THE BEST OF MY KNOWLEDGE AND BELIEF.

PROFESSIONAL LAND SURVEYOR

1-4-18 DATE

- TIE SKETCH

NOTE: THE CORNER FALLS 332'± EAST OF THE CENTERLINE OF CTH G.



N 86°08'39" W 300.90 (5) CTH FIELD.

 3/4" x 18" IRON REBAR SET, 1.50#/FT HARRISON FOUND

→ VINYL "T" POST

ADAMS COUNTY

Survey Monument Record

TYPE OF MONUMENT: Harrison Monument

STATE PLANE COORDINATES: N_

ELEVATION - M.S.L. DATUM: _

THETA ANGLE: .

FIELD BOOK: ___ PAGE _

BASIS FOR MONUMENT LOCATION


(Use reverse side if necessary)

Show info such as: History of corner, with reference to Vol. and pg, dates, surveyor; exact description of monument replaced; if location computed, by taped or EDM traverse; landowner

Ran EDM/travsit traverse around Sections 27, 32, 33 and 34, and to adjacent section corners to determine search area.

Did not excavate because search area falls within cultivated field.

Re-established corner by single proportionate measure on line between adjacent section corners. Set 10-25-76.

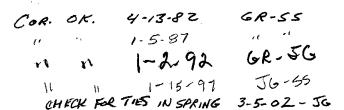


CORNER NO. 34 SECTION 16 TOWN RANGE





CERTIFIED CORRECT Registered Land Surveyor

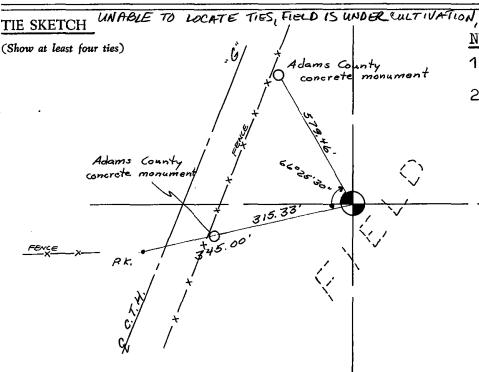

NOTES:

SEAL:

1) No other bearing objects available.

6-20-07-56

2) Monument placed below plow depth.