OT ADAMS COUNTY

COUNTY CORNER NO: 129

ROMPORTOL ID: 41607340 00


PUBLIC LAND SURVEY MONUMENT RECORD

3/4" x 48" IRON REBAR TYPE OF MONUMENT: ADAMS COUNTY COORDINATES, NAD 83 (2007) N. **164756.716** E. <u>578538.898</u> **ELEVATION-**DATUM FIELD WORK DATE: 12/13/2017


BASIS FOR MONUMENT LOCATION

1975 - PLS 1103 RAN EDM/TRANSIT TRAVERSE AROUND SECTIONS 27, 34 AND PARTS OF SECTIONS 26 AND 35. COULD NOT FIND ANY EVIDENCE OF THE ORIGINAL CORNER OR ANY REMONUMENTATION. RE-ESTABLISHED THE CORNER BY SINGLE PROPORTIONATE MEASUREMENT BETWEEN THE SOUTHWEST CORNER OF SECTION 34 AND THE SOUTH QUARTER CORNER OF SECTION 35. SET A NAIL AND DISC IN A NOTCH OF A TREE AND TIED

2017 - PLS 2994 FOUND A PK NAIL AND DISC IN A TWIN PINE STUMP, ALL OF THE TIES WERE DESTROYED DUE TO LOGGING. THE STUMP WAS DETERIORATING AND THE PK NAIL WAS NOT IN A STABLE POSITION. REMOVED THE PK NAIL, BROKE AWAY ENOUGH OF THE STUMP REMAINS TO SET A 3" x 48" IRON REBAR AT THE PRIOR PK NAIL LOCATION. SET 4 NEW TIES AND MEASURED TO THE TIES.

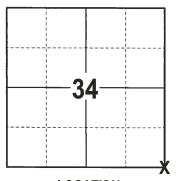

LOCATION (INDICATE CORNER BY "X")

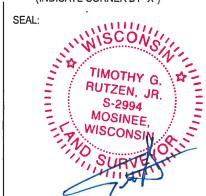


DATA SHOWN HERE ON THIS TIE SHEET IS CORRECT AND COMPLETE TO THE BEST OF MY KNOWLEDGE AND BELIEF.

PROFESSIONAL LAND SURVEYOR

DATE

- TIE SKETCH



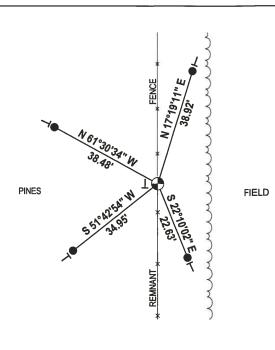

● 3/4" x 18" IRON REBAR SET, 1.50#/FT 🕀 3/4" x 48" IRON REBAR SET, 1.50#/FT → VINYL "T" POST

CORNER NO. ADAMS COUNTY SECTION Survey Monument Record 16 TOWN TYPE OF MONUMENT: Nail and Disc in Notch of Tree **RANGE** STATE PLANE COORDINATES: N. ELEVATION - M.S.L. DATUM: . THETA ANGLE: _ PAGE . FIELD BOOK: ___ BASIS FOR MONUMENT LOCATION (Use reverse side if necessary) LOCATION Show info such as: History of corner, with reference to Vol. and pg, dates, surveyor; exact description of monument replaced; if location computed, by taped or EDM traverse; landowner (Indicated by 'X') SEAL: remarks, etc. Ran EDM/transit traverse around Sections 27 and 34, and parts of Sections 26 and 35. Could find no evidence of the original corner or DALE C. any remonumentation. HAGEN S-1103 Wisconsin Rapids Re-established corner by single proportionate measure between the Southwest corner of Section 34 and the South Quarter corner of Section 35. COKNER 10-28.76 4-13-82 1-5-87 6R-56 1-2-92 1-15-97 JG-55 3-5-02 AREA LOGGED OFF ALL TREES CUT GRNER NEEDS TO RESET, 6-20-07-50 (Show at least four ties) 3'± Sε

REVISED 1974