
LAND CORNER MONUMENT INDEX

Corner Monumented
Tie Sheet Filed in Adjoining
Township as Indicated

- Corner Monumented
 Tie Sheet In This Book
- Corner May or May Not

 Be Monumented -- No Ties

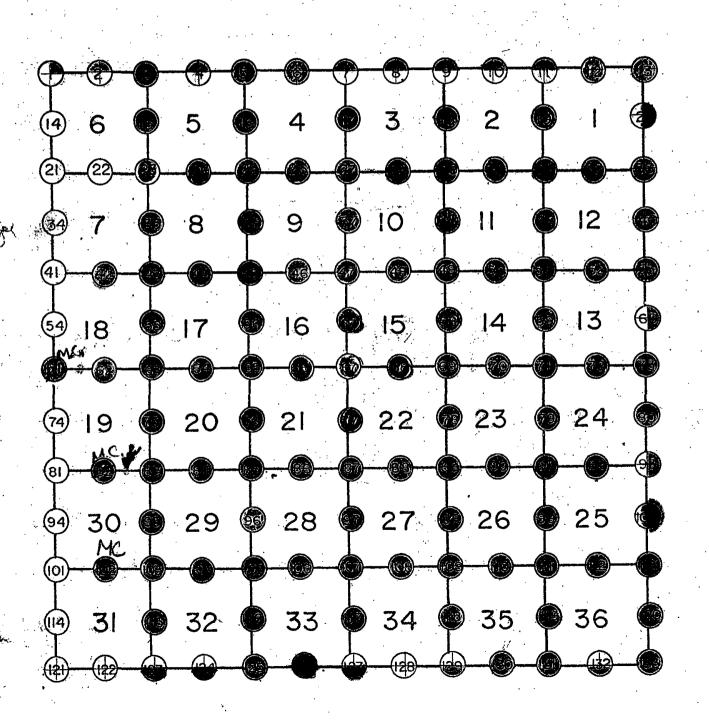




Government Land Corner Certificate Apars ______ County Type of monument: Harrison STATE PLANE COORDINATES: N______ ELEVATION — M.S.L. DATUM: ______ THETA ANGLE: ______ FIELD BOOK: ______/0/____ PAGE _7.5____

BASIS FOR MONUMENT LOCATION

DRAWN BY: (Z.v.

Show info such as: History of corner, with reference to Vol. and pg., dates, surveyor; exact description of monument replaced; if location computed, by taped or EDM traverse; landowner remarks, etc. (Use reverse side if necessary)

Initially used the Harrison monument set by Sam Mullen from a concrete reference monument. (see sketch) After running a complete traverse of Sec. 32, I was certain that the Harrison monument was in an erroneous location by approximately 66 feet. Using the tie to the corner called for from a cemetary to the south, I excavated with a backhoe. Found nothing. After doing further investigation, such as the tie to the corner from the railroad map, I excavated further for the stone called for by M.C.Smith in his plats of Holmsville. Again found nothing. I then dug for the stone forty corner he called for in the Holm's addition. This I found. I then remeasured and rex excavated further and immediately found the stone marking the SW corner of Sec. 32. 65.04' south of Mullen's Harrison. (over for more detail)

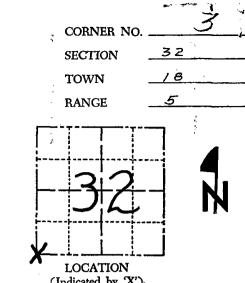

SEAL:



DATA SHOWN HERE ON CERTIFIED CORRECT:

Registered Land Surveyor

DATE: 4/27/77


TIE SKETCH

Show at least four ties, also fence lines, roads, topo, size and type of witness trees' and if off road - best way to arrive at corner.

OK 11-17-78 RN.SS OK 5/29/85 D.K.

MAINTENANCE RECORD

Date	Init.	Remarks	
1-30-90	12.55	3 NEW	
8-17-94	16-55	OK	
11-27-00		0K .	
-15-05	DA/56	oK_	

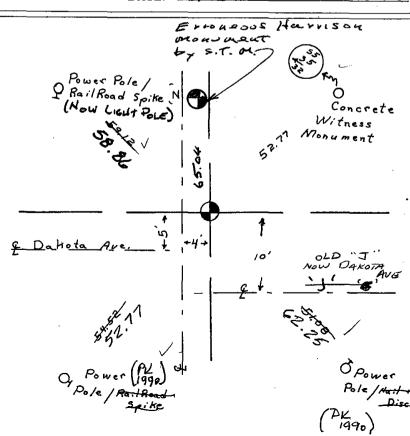

Basis for corner (con't)

The stone found was an 8 x 5" sandstone(white). I broke the top 7" off when I hit it with the backhoe. The remainder of the stone remained in place. The stone in place was witnessed by William Ryman, Adams County Zoning Administrator. I left the bottom part of the stone undisturbed and in place and set a Harrison monument on top.. I put the broken off part of the stone along the north side of the bottom of the Harrison. The stone had a drill hole in it.

See file 32-18-5 for Mr. Ryman's affidavit regarding his witnessing the excavation of the stone.

In his tie from the stone to the corner of Holm's Addition, M.C.Smith has an erroneous dimension of N $10^{\rm O}$ W $156\frac{\rm I}{\rm 2}$ links. I believe this should have been N $10^{\rm O}$ W $256\frac{\rm I}{\rm 2}$ links. This will then get, a dimension of 33'± from the stone to the west line of CTH "Z", which is what he obviously intended.