02 SECTION 17

ADAMS COUNTY COUNTY COUNTY CORNER NO: 30 ROMPORTOL ID: 41705020020


PUBLIC LAND SURVEY MONUMENT RECORD

HARRISON TYPE OF MONUMENT: ADAMS COUNTY COORDINATES, NAD 83 (2007) N. 218643.626 E. 517841.055 ELEVATION-_ DATUM 12/20/2018 FIELD WORK DATE:


BASIS FOR MONUMENT LOCATION

1975 - PLS 922 FOUND NO EVIDENCE OF THE ORIGINAL CORNER, CALCULATED THE CORNER LOCATION EQUIDISTANT BETWEEN THE SOUTHWEST CORNER AND SOUTHEAST CORNER; FIT REMNANTS OF OLD EAST-WEST FENCE GOOD. SET A HARRISON MONUMENT AND TIED OUT CORNER.

2018 - PLS 2675 FOUND A HARRISON MONUMENT 6" ABOVE THE GROUND SURFACE AND 1 WITNESS TREE. THE MONUMENT AGREES WITH THE EXISTING WITNESS TREE. ACCEPTED THE HARRISON MONUMENT AS THE CORNER LOCATION. SET 4 NEW TIES AND MEASURED TO THE TIES AND WITNESS TREE.

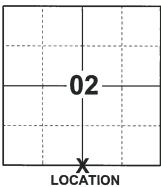

(INDICATE CORNER BY "X")

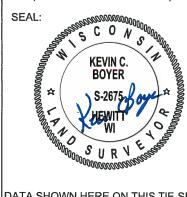

DATA SHOWN HERE ON THIS TIE SHEET IS CORRECT AND COMPLETE TO THE BEST OF MY KNOWLEDGE AND BELIEF.

PROFESSIONAL LAND SURVEYOR


DATE 1-18-19

-TIE SKETCH -

NOTE: THE CORNER FALLS 242'± SOUTHWEST OF THE R.R. TRACKS.



- SET 3/4" x 18" IRON REBAR, 1.50#/FT
- FOUND HARRISON MONUMENT
- VINYL "T" POST
- WITNESS TREE

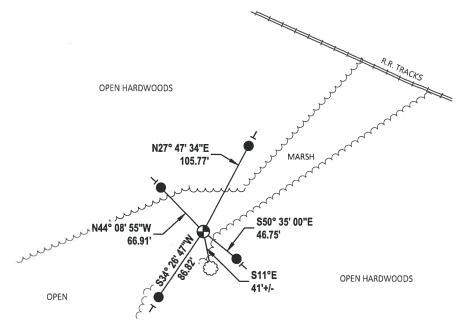

ADAMS COUNTY CORNER NO. SECTION Survey Monument Record 17 **TOWN** HARRISON MONUMENT TYPE OF MONUMENT: ___ 5 RANGE STATE PLANE COORDINATES: N. ELEVATION - M.S.L. DATUM: _ THETA ANGLE: __ FIELD BOOK: _ PAGE BASIS FOR MONUMENT LOCATION (Use reverse side if necessary) LOCATION Show info such as: History of corner, with reference to Vol. and pg, dates, surveyor; exact description of monument replaced; if location computed, by taped or EDM traverse; landowner (Indicated by 'X') SEAL: remarks, etc. anninn, Could find no evidence of original corner. Reset corner equadistant between southwest FREDERIC corner and southeast corner; fit remnants of old east-west fence ZIETLOW E.D.M. traverse. S-922 FOLLOW TRACKS TO 23RD +24TH POLÉ FROM Baraboo IGTH AVE, WALK SOUTH BETWEEN THERE I 300' TIES + MON OK I NEW ME 1-3-95 85-55 CERTIFIED CORRECT: 0.1 10-31-75 0.111 5.5 Registered Land Surveyor ALL OK 30' BLACK ONES TIE SKETCH (Show at least four ties) SWITCH 10' STUB) 33RD HOUSE NAIL WEST SIDE 12" 6"BUR 10't TALL 5748-199 199 O 141 W W 300 200 40.2 POLE REMNANTS OF OLD DOWN FENCE DNO SIGN

POST I SOUTH 1994 FULLOST WONDSIGN

NAIL EAST SIDE NO.

NAIL EAST SIDE

NAIL EAST SIDE

8" JACK PINE

GONE 6"

NAIL STILL COOD 40.8'