

PUBLIC LAND SURVEY MONUMENT RECORD

TYPE OF MONUMENT: HARRISON
 ADAMS COUNTY COORDINATES, NAD 83 (2007)

N. 218831.180

E. 525683.436


ELEVATION- DATUM

FIELD WORK DATE: 06/13/2017

BASIS FOR MONUMENT LOCATION

1978- PLS 878 FOUND AN IRON BAR AS MONUMENT. EXCAVATED WITH A BACKHOE FOUND NO OTHER EVIDENCE OF ANY PREVIOUS MONUMENTATION. SET A HARRISON MONUMENT AT LOCATION AND 4 WITNESSES.

2017 - PLS 2994 FOUND HARRISON MONUMENT 2" BELOW THE ROAD SURFACE AND 2 TIES. THE MONUMENT AGREES WITH THE EXISTING TIES. ACCEPTED HARRISON AS CORNER LOCATION, SET 2 NEW TIES AND RE-MEASURED TO THE EXISTING TIES.

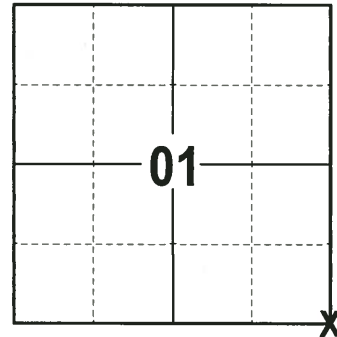

LOCATION
 (INDICATE CORNER BY "X")

SEAL:





DATA SHOWN HERE ON THIS TIE SHEET IS CORRECT AND COMPLETE TO THE BEST OF MY KNOWLEDGE AND BELIEF.

PROFESSIONAL LAND SURVEYOR

DATE 6/26/17

- TIE SKETCH

NOTE: THE CORNER FALLS 2± NORTH OF THE CENTERLINE OF DEERBORN AVE.

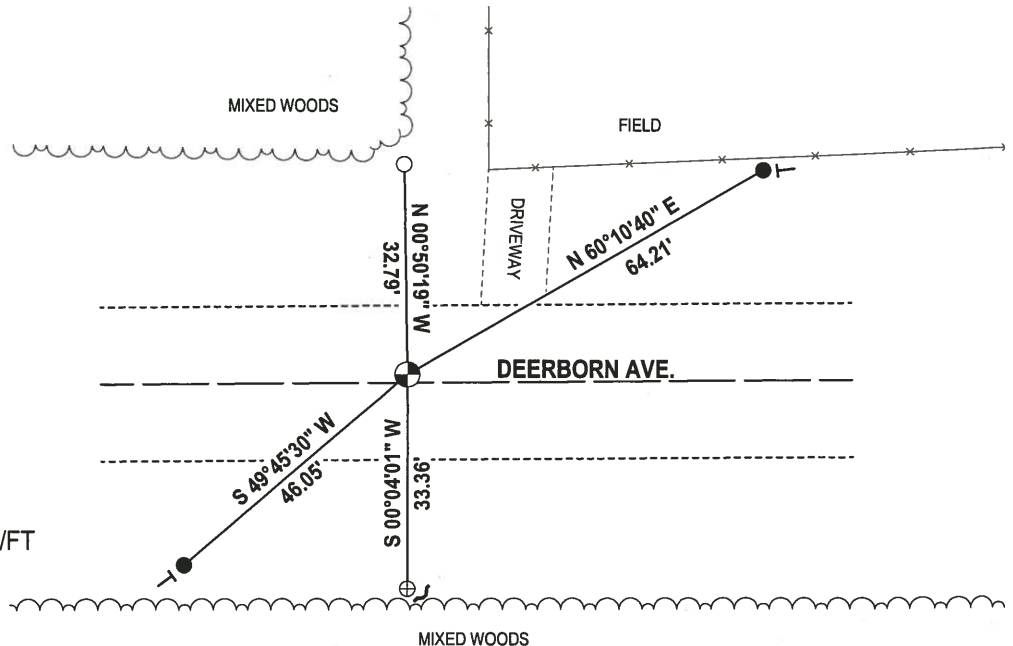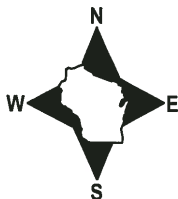


- 3/4" x 18" IRON REBAR SET, 1.50#/FT
- 3/4" IRON ROD FOUND
- ⊕ 1-1/4" O.D. IRON PIPE FOUND
- ⊙ HARRISON FOUND
- ↙ STEEL FENCE POST
- └ VINYL "T" POST

Government Land Corner Certificate

ADAMS County
 TYPE OF MONUMENT: HARRISON
 STATE PLANE COORDINATES: N _____
 E _____
 ELEVATION — M.S.L. DATUM: _____
 THETA ANGLE: _____
 FIELD BOOK: 57 PAGE 69
 DRAWN BY: B. MERZ

CORNER NO. 33
 SECTION 12
 TOWN 17
 RANGE 5

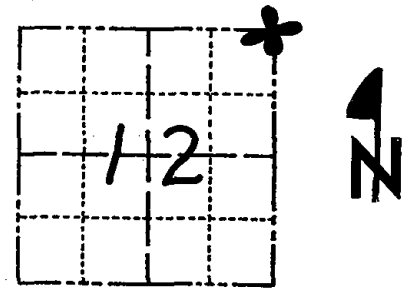

LOCATION
 (Indicated by 'X')

BASIS FOR MONUMENT LOCATION

Show info such as: History of corner, with reference to Vol. and pg., dates, surveyor; exact description of monument replaced; if location computed, by taped or EDM traverse; landowner remarks, etc. (Use reverse side if necessary)

Monumented existing iron bar that had been used by other surveyors as the corner, after excavation with the backhoe yielded no other evidence of any previous monumentation.

SEAL:




DATA SHOWN HERE ON
 CERTIFIED CORRECT:

Anthony B. Kiedrowski
 Registered Land Surveyor

DATE: 8-1-78

TIE SKETCH

Show at least four ties, also fence lines, roads, topo, size and type of witness trees' and if off road - best way to arrive at corner.

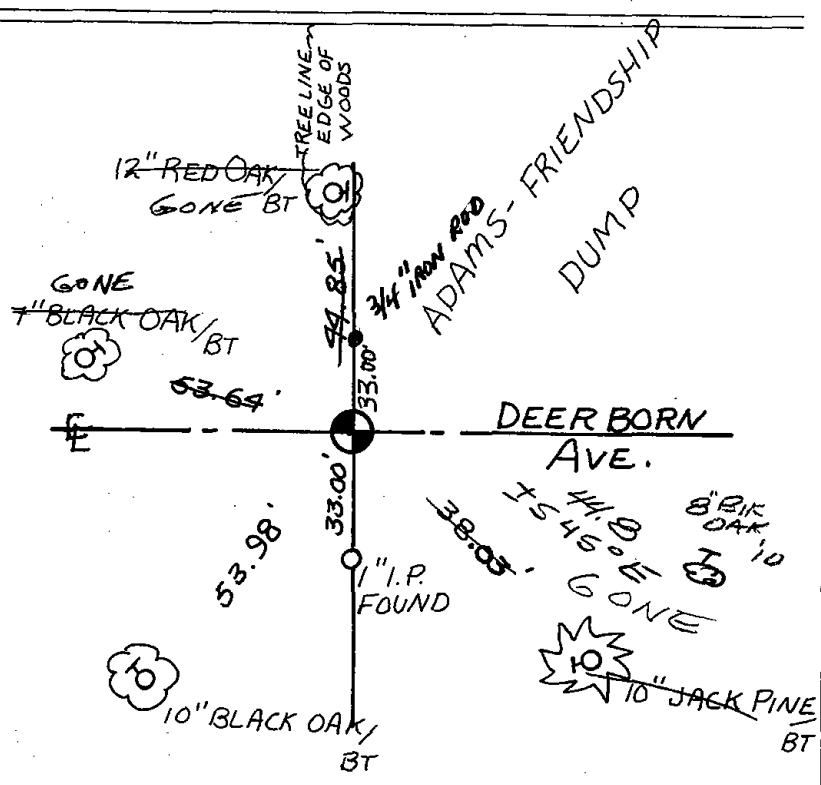

MAINTENANCE RECORD

Date	Init.	Remarks
8/27/80	RN-TH	mon OK
10-21-85	MB-SS	gone - 4 remain OK
2-5-90	KZ-SS	OK
8-8-94	CR-JG	OK
2-14-00	SS	OK
2-7-05	JG	OK
12-15-10	SS	1 NEW TIE