05 ADAMS COUNTY CORNER NO: 35 RANGE ADAMS COUNTY CORNER NO: 41705072000

PUBLIC LAND SURVEY MONUMENT RECORD

HARRISON TYPE OF MONUMENT: ADAMS COUNTY COORDINATES, NAD 83 (2007)

N. 215893.032

E. 499427.505


ELEVATION- - - DATUM - -

01/16/2019 FIELD WORK DATE:


BASIS FOR MONUMENT LOCATION

1975 - PLS 1103 RETRACED SURVEY BY F.W. ZIETLOW IN THE NW1/4 OF THE NW1/4 OF SECTION 8. SET CORNER AT LOCATION AS INDICATED ON CSM FOR ABOVE NOTED SURVEY, RECORDED NOVEMBER 4, 1970[VOL. 1 PAGE 94 OF CERTIFIED SURVEYS.

2019 - PLS 2675 FOUND HARRISON MONUMENT 4" BELOW THE ROAD SURFACE AND 1 TIE. THE MONUMENT AGREES WITH THE EXISTING TIE. ACCEPTED THE HARRISON AS THE CORNER, SET 4 NEW TIES AND MEASURED TO THE EXISTING TIE.

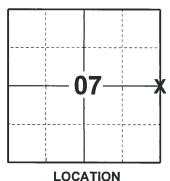

(INDICATE CORNER BY "X")

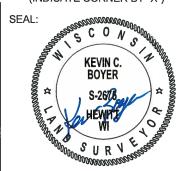

DATA SHOWN HERE ON THIS TIE SHEET IS CORRECT AND COMPLETE TO THE BEST OF MY KNOWLEDGE AND BELIEF.

PROFESSIONAL LAND SURVEYOR


DATE

-TIE SKETCH

NOTE: THE CORNER LANDS 0.50'± EAST OF CENTER LINE OF CTH "Z"



- SET 3/4" x 18" IRON REBAR, 1,50#/FT
- O FOUND 3/4" IRON ROD
- FOUND HARRISON MONUMENT
- STEEL FENCE POST
- VINYL "T" POST
- RIGHT OF WAY GUARD POST

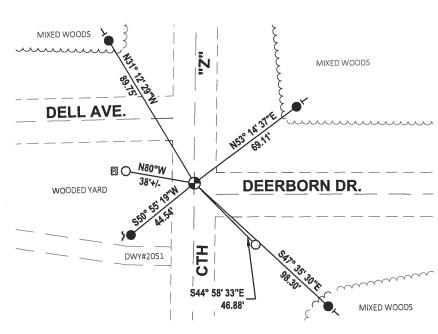

ADAMS COUNTY

Survey Monument Record

TYPE OF MONUMENT: Harrison Monument STATE PLANE COORDINATES: N.

ELEVATION - M.S.L. DATUM: _

THETA ANGLE: __

FIELD BOOK: _ **PAGE**

BASIS FOR MONUMENT LOCATION

(Use reverse side if necessary)

Show info such as: History of corner, with reference to Vol. and pg, dates, surveyor; exact description of monument replaced; if location computed, by taped or EDM traverse; landowner

Retraced survey by F. W. Zietlow in the NW% of the NW of Section 8.

Set corner at location as indicated on CSM for above noted survey, recorded November 4, 1970, Vol. 1, page 94 of Certified Surveys.


MON + TIES OK KV-SK 9/26/80

1 GONE NO NEW 5/30/85 DK, 3 NEW TIES 1-30-90 KZ-SS

400 SPIKES

REVISED 1974

1-GONE, 1-NEW, 2-7-00, JG-SS 2-GONE, 3-NEW, 2-11-05 JG-DA 12-16-10 OK

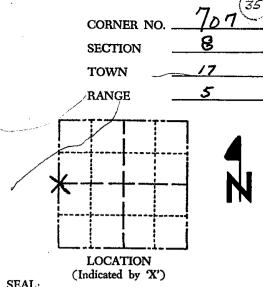

SEAL:



