OS ADAMS COUNTY COUNTY CORNER NO: 48

ROMPORTOL ID: 41705100020


PUBLIC LAND SURVEY MONUMENT RECORD

HARRISON TYPE OF MONUMENT: ADAMS COUNTY COORDINATES, NAD 83 (2007) N. 213298.444 E. 512574.649 **ELEVATION-**DATUM 01/02/2019 FIELD WORK DATE:


BASIS FOR MONUMENT LOCATION

1980 - PLS 1478 CALCULATED THE CORNER LOCATION ON LINE BETWEEN ADJACENT SECTION CORNERS AND PROPORTIONATE TO M.C. SMITH'S NOTES OF SEPT. 1920 AS RECORDED IN VOL. 2 PAGE 77 ACSR. I WAS UNABLE TO LOCATE ANY OF SMITH'S EVIDENCE. SET A HARRISON MONUMENT AT THE CALCULATED LOCATION AND TIED

2019 - PLS 2675 FOUND A HARRISON MONUMENT FLUSH WITH THE GROUND SURFACE AND 2 WITNESS TREES. THE MONUMENT AGREES WITH THE EXISTING WITNESS TREES. ACCEPTED THE HARRISON MONUMENT AS THE CORNER LOCATION. SET 4 NEW TIES AND MEASURED TO THE TIES AND WITNESS TREES.

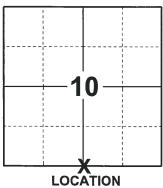

(INDICATE CORNER BY "X")

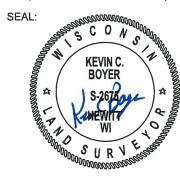


DATA SHOWN HERE ON THIS TIE SHEET IS CORRECT AND COMPLETE TO THE BEST OF MY KNOWLEDGE AND BELIEF.

PROFESSIONAL LAND SURVEYOR

-TIE SKETCH -

NOTE: THE CORNER LANDS 5'± NORTH OF THE WOODS TRAIL.



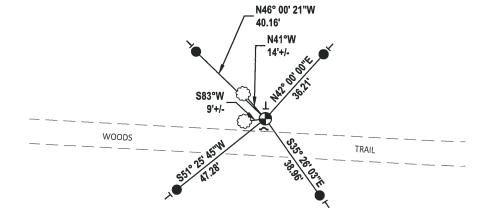

- SET 3/4" x 18" IRON REBAR, 1.50#/FT
- FOUND HARRISON MONUMENT
- STEEL FENCE POST
- VINYL "T" POST
- WITNESS TREE

S. 146. 4/21/80 Government Land Corner Certificate RN-SS 48 CORNER NO. County TEMP. IRON 10 **SECTION** Harrison ~ to REPLACED TYPE OF MONUMENT: _ 8€ 17 TOWN STATE PLANE COORDINATES: 5 **RANGE** E. ELEVATION — M.S.L. DATUM: _ THETA ANGLE: __ FIELD BOOK: _____83 _ PAGE __/36 DRAWN BY: G.P.R. BASIS FOR MONUMENT LOCATION Show info such as: History of corner, with reference to Vol. and pg., dates, surveyor; exact description of monument replaced; if location computed, by taped or EDM traverse; landowner remarks, etc. (Use reverse side if necessary) LOCATION (Indicated by 'X') SEAL: GREGORY P. RHINEHART S-1478 Wisconsin Rapids Wis. Set on line between adjacent section corners and proportionate to M.C. Smith's notes of Sept. 1920 as recored in Nol. 2 page 77 ACSR. I was unable to look locate any of Smith's evidence. FND STEEL POST At CORNER - OK 1-29-90 KZ-SS 2-GONE, 2-NEW 1-6-95 JG-BS 3 REMAINING THE 12-28-99 NOTHING AVAILABLE 55 1-NEW 2/10/05 - JG-SS Z NEW 9-2-10 SS DATA SHOWN HERE ON CERTIFIED CORRECT: DATE: TIE SKETCH Show at least four ties, also fence lines, roads, topo, size and type of witness trees' and if off road - best way to arrive at corner.

WETAL TOPOST TO STANDER INC. 28.50' A STANDER TO STANDE

GONE

MAINTENANCE RECORD

DATE	BY WHOM	REMARKS
10-21-85	MB-SS	ALL O.K.