ADAMS COUNTY COUNTY COUNTY CORNER NO: 56 ROMPORTOL ID: 41705172000

PUBLIC LAND SURVEY MONUMENT RECORD

HARRISON (BROKEN-TOP) TYPE OF MONUMENT: ADAMS COUNTY COORDINATES, NAD 83 (2007)

N. 210641.549

E. 504710.807

DATUM - ---ELEVATION-

FIELD WORK DATE: 01/30/2019


BASIS FOR MONUMENT LOCATION

1975 - PLS-1103 SET CORNER EQUIDISTANT AND ON LINE BETWEEN ADJACENT SECTION CORNERS. COULD FIND NO EVIDENCE OF THE ORIGINAL CORNER OR ANY SUBSEQUENT REMONUMENTATION.

2019 - PLS-2675 FOUND HARRISON MONUMENT (BROKEN-TOP) 18" BELOW THE SURFACE AND 1 TIE. THE MONUMENT AGREES WITH THE EXISTING TIE. ACCEPTED THE HARRISON MONUMENT (BROKEN-TOP) AS THE CORNER. SET 3 NEW TIES AND MEASURED TO EXISTING TIE.



(INDICATE CORNER BY "X")

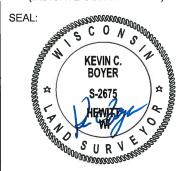

DATA SHOWN HERE ON THIS TIE SHEET IS CORRECT AND COMPLETE TO THE BEST OF MY KNOWLEDGE AND BELIEF.


PROFESSIONAL LAND SURVEYOR

-TIE SKETCH

NOTE: THE CORNER LANDS 11'± WEST OF CENTERLINE OF 18TH AVE.



- SET 3/4" x 18" IRON REBAR, 1.50#/FT
- FOUND 1-1/4" O.D. IRON PIPE
- FOUND HARRISON MONUMENT (BROKEN-TOP)
- STEEL FENCE POST
- VINYL "T" POST

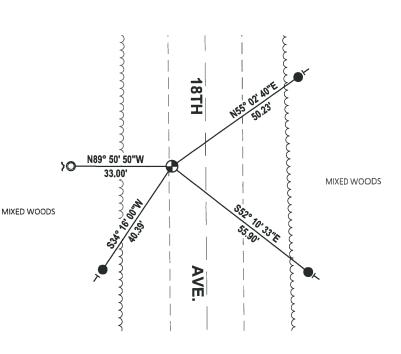

ADAMS COUNTY

Survey Monument Record

TYPE OF MONUMENT: Harrison Standard STATE PLANE COORDINATES: N_ E_ ELEVATION — M.S.L. DATUM: ____ THETA ANGLE: _ FIELD BOOK: __ _____ PAGE _

SECTION	17
TOWN	17
RANGE	6
	* N

LOCATION

(Indicated by 'X')

HAGEN S-1103 Wisconsin Rapids,

SEAL:

CORNER NO.

BASIS FOR MONUMENT LOCATION

(Use reverse side if necessary)

Show info such as: History of corner, with reference to Vol. and pg, dates, surveyor; exact description of monument replaced; if location computed, by taped or EDM traverse; landowner

Set corner equidistant and on line between adjacent Section corners

Could find no evidence of the original corner or any subsequent remonumentation.

MON + TIES OK RN-TH 8/27/80

Ties all ok, monument Has Broken Top 5/23/85 DK OK 1-29-90 KZ-SS ALL OK 8-29-94 JG-SS 1-GONE, 1-NEW, 1-10-00, JG=SS ALL OK 2,-14-05, JG-DA 2-16-10 SS

TIE SKETCH

(Show at least four ties) @ Woods Trail + 8"Twin DND SIGN IRON DIPE NOTE: Ties in trees to nail in disc. 8"81K. Oak

