ADAMS COUNTY COUNTY COUNTY CORNER NO: 58 ROMPORTOL ID: 41705152000

PUBLIC LAND SURVEY MONUMENT RECORD

TYPE OF MONUMENT:	HARRISON
ADAMS COUNTY COORDINATE	S, NAD 83 (2007)

N. 210686.041

E. 515217.682

ELEVATION-DATUM

01/29/2019 FIELD WORK DATE:


BASIS FOR MONUMENT LOCATION

1977 - PLS-1103 RAN EDM/T2 TRAVERSE AROUND SECTION 11 AND THE WEST LINE OF SECTION 14 TO DETERMINE SEARCH AREA FOR INVESTIGATION. EXCAVATION WITH BACKHOE YIELDED NO EVIDENCE OF THE ORIGINAL CORNER OR ANY REMONUMENTATION. COULD FIND NO BEARING TREES. RELOCATED CORNER HALFWAY AND ON LINE BETWEEN THE NORTHWEST AND SOUTHWEST CORNERS OF SECTION 14.SET HARRISON MONUMENT.

2019 - PLS-2675 FOUND HARRISON MONUMENT 12" BELOW THE ROAD SURFACE AND 1 TIE. THE MONUMENT AGREES WITH THE TIE. ACCEPTED THE HARRISON MONUMENT AS THE CORNER. SET 3 NEW TIES AND MEASURED TO THE EXISTING TIE.



(INDICATE CORNER BY "X")

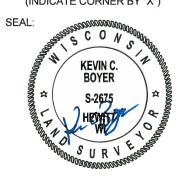

DATA SHOWN HERE ON THIS TIE SHEET IS CORRECT AND COMPLETE TO THE BEST OF MY KNOWLEDGE AND BELIEF.


PROFESSIONAL LAND SURVEYOR

- TIE SKETCH

NOTE: THE CORNER LANDS 1.5'± EAST OF CENTER OF 16TH AVE.



- SET 3/4" x 18" IRON REBAR, 1.50#/FT
- FOUND 1" O.D. IRON PIPE
- FOUND 1-1/4" O.D. IRON PIPE
- FOUND HARRISON MONUMENT
- STEEL FENCE POST
- VINYL "T" POST

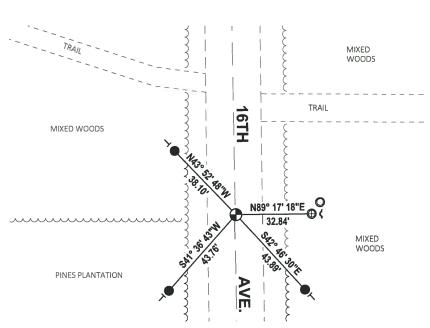

Government Land Corner Certificate

ADAMS	County
TYPE OF MONUMENT: Harrison	
STATE PLANE COORDINATES: N	······
· <u>E</u>	
ELEVATION — M.S.L. DATUM:	·
THETA ANGLE:	
FIELD BOOK: 57	PAGE _26
DRAWN BY: Roger Nuber	<u> </u>
	•

BASIS FOR MONUMENT LOCATION

Show info such as: History of corner, with reference to Vol. and pg., dates, surveyor; exact description of monument replaced; if location computed, by taped or EDM traverse; landowner remarks, etc. (Use reverse side if necessary)

Ran EDM/T2 traverse around Section 11 and the West line of Section 14 to determine search area for investigation.

Excavation with backhoe yielded no evidence of the original corner or any remonumentation. Could find no bearing trees.

Relocated corner half way and on line between the Northwest and Southwest corners of section 14.


Set Harrison Monument.

 CORNER NO.
 58

 SECTION
 /4

 TOWN
 /7

 RANGE
 5

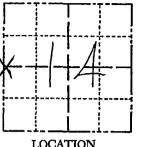



LOCATION
Indicated by 'X')



DATA SHOWN HERE ON CERTIFIED CORRECT:

Registered Land Surveyor


DATE: 11-9-1977

TIE SKETCH

Show at least four ties, also fence lines, roads, topo, size and type of witness trees' and if off road - best way to arrive at corner.

NOTE

Ties in trees to nail in disc.

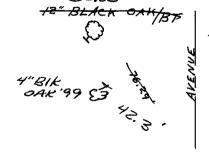

OAK/B7

AN 38 OF OAKING

CAPPED IRON PIPE

DIZ BLACK OAK/BT

MAINTENANCE RECORD

Date	Init.	Remarks
9/26/80	KU-SK	MON YTIES OK
5/29/85	DK	ALL OK
6-1-90	36-55	ALL OK
1-6-95	36-85	ALL OK
12-3-99	16 - 2 5	INOW THE
8.7-05	56	I-GONE I-NEW
2-12-10	5<	INON TIE

REVISED 1977

