O5 RANGE ADAMS COUNTY C


PUBLIC LAND SURVEY MONUMENT RECORD

HARRISON (BROKEN-TOP) ADAMS COUNTY COORDINATES, NAD 83 (2007) N. 208001.543 E. 507349.055 **ELEVATION-**DATUM 01/03/2019 FIELD WORK DATE:_


BASIS FOR MONUMENT LOCATION

1980 PLS 1444 CALCULATED THE CORNER LOCATION EQUIDISTANT AND ON LINE BETWEEN SECTION CORNERS. NO EVIDENCE OF ORIGINAL CORNER OR ANY RESURVEY CORNER. SET A HARRISON MONUMENT AT THE CALCULATED LOCATION

2019 - PLS 2675 FOUND A 1" IRON ROD LEANING AND UP 12". REMOVED THE 1" IRON ROD AND FOUND A HARRISON MONUMENT WITH A BROKEN-TOP 24" BELOW GROUND SURFACE. FOUND NO EVIDENCE OF ANY OF THE EXISTING TIES OR WITNESSES. ACCEPTED THE HARRISON MONUMENT WITH A BROKEN-TOP AS THE BEST EVIDENCE OF THE CORNER LOCATION. SET 4 NEW TIES AND MEASURED TO THE TIES.

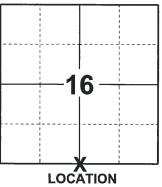

(INDICATE CORNER BY "X")

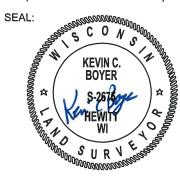

DATA SHOWN HERE ON THIS TIE SHEET IS CORRECT AND COMPLETE TO THE BEST OF MY KNOWLEDGE AND BELIEF.

PROFESSIONAL LAND SURVEYOR

1-18-19

-TIE SKETCH

NOTE: THE CORNER FALLS 66'± NORTH OF THE NORTH GATE POST.




MIXED WOODS

SET 3/4" x 18" IRON REBAR, 1,50#/FT

FOUND HARRISON MONUMENT (BROKEN-TOP)

STEEL FENCE POST

VINYL "T" POST

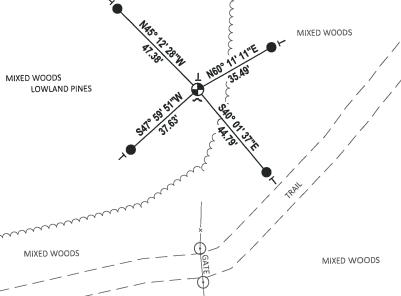

Government Land Corner Certificate CORNER NO. ___ ADAMS County 16. SECTION TYPE OF MONUMENT: _HARRISON TOWN STATE PLANE COORDINATES: N 43°56'14.1" HAND HELD GRS 2010 E 089°54' 27 2 F 089°54' 27.3" RANGE ELEVATION — M.S.L. DATUM: _ THETA ANGLE: ____ 77 FIELD BOOK: __ DRAWN BY: LANCE HABECK BASIS FOR MONUMENT LOCATION Show info such as: History of corner, with reference to Vol. and pg., dates, surveyor; exact description of monument replaced; if location computed, by taped or EDM traverse; landowner remarks, etc. (Use reverse side if necessary) LOCATION (Indicated by 'X') SEAL: HARING CONSTANT This corner was set equidistant and on line between section corners. No evidence of original corner or any resurvey corner. LANCE J. HABECK S-1444 Stevens Point, Wis-DATA SHOWN HERE ON CERTIFIED CORRECT: Registered Land Surveyo TIE SKETCH Show at least four ties, also fence lines, roads, topo, size and type of witness trees' and if off road - best way to 1-29-90 KZ-SS Z-NEW 1-4-95 56-85 - ONE 95' COMPLETE AREA PULPED OFF, COULDN'T FIND! 12" OF HARR. BROKE OFF SET 14"x30" >N TOP DND SIGN HARRISON 2-2-95 JG-GR DND SIGN I-NEW TIE BRONG JACKPINE STEEL POST FOR GRNER BT/ DND SIGN NEXT TIME 1-10-00 JG-55 4 NEW TIES Z-15-05 DA/JG DOWN

OK 11-17-10 GR

MAINTENANCE RECORD

DATE	BY WHOM		REMARKS	
9-85	MB - 55		OK	
		·		
	·			