

PUBLIC LAND SURVEY MONUMENT RECORD

TYPE OF MONUMENT: HARRISON
 ADAMS COUNTY COORDINATES, NAD 83 (2007)

N. 208140.498

E. 520474.977


ELEVATION: _____ DATUM _____

FIELD WORK DATE: 01/07/2019

BASIS FOR MONUMENT LOCATION

1976 - PLS-922 CHECKED ADAMS COUNTY SURVEY RECORDS AND FOUND THAT M.C. SMITH SET OUT 2 BEARING TREES IN 1921. MADE A THOROUGH SEARCH AND FOUND NO EVIDENCE OF THEM FOUND A 4" CEDAR POST SET BY NEKOOSA-EDWARDS PAPER CO. AND ACCEPTED AS CORNER. FIT EDM TRAVERSE OF SECTION EXCELLENT.

2019 - PLS-2675 FOUND HARRISON MONUMENT 2" BELOW THE GROUND SURFACE AND 2 WITNESS TREES. THE MONUMENT AGREES WITH BOTH WITNESS TREES. ACCEPTED THE HARRISON MONUMENT AS THE CORNER. SET 4 NEW TIES AND MEASURED TO THE EXISTING WITNESS TREES.

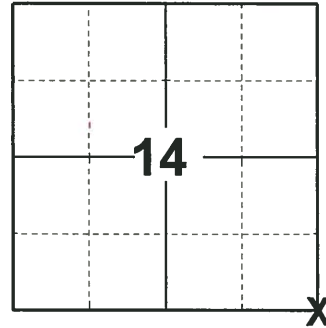

LOCATION

(INDICATE CORNER BY "X")

SEAL:



DATA SHOWN HERE ON THIS TIE SHEET IS CORRECT AND COMPLETE TO THE BEST OF MY KNOWLEDGE AND BELIEF.


PROFESSIONAL LAND SURVEYOR

DATE 3/12/19

- TIE SKETCH



- SET 3/4" x 18" IRON REBAR, 1.50#/FT
- ⊙ FOUND HARRISON MONUMENT
- VINYL "T" POST
- ☼ WITNESS TREE

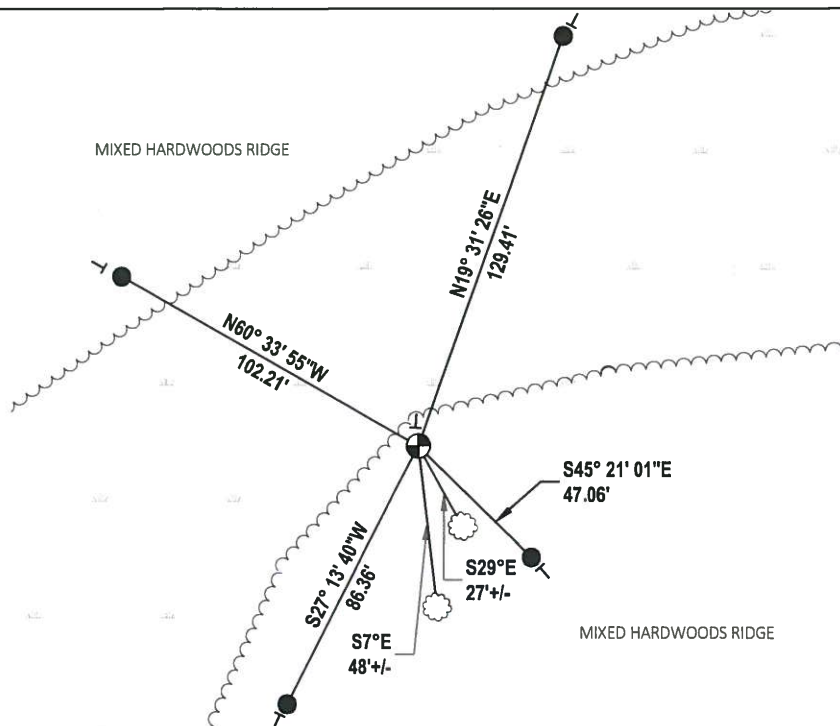

ADAMS COUNTY

Survey Monument Record

TYPE OF MONUMENT: 30" STANDARD HARRISON

STATE PLANE COORDINATES: N _____

E _____

ELEVATION — M.S.L. DATUM: _____

THETA ANGLE: _____


FIELD BOOK: _____ PAGE _____

CORNER NO. 71

SECTION 23


TOWN 17N

RANGE 5E

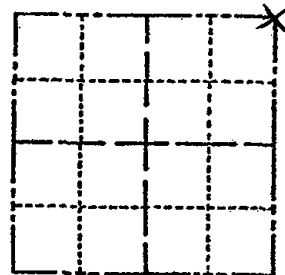

LOCATION
(Indicated by 'X')

SEAL:

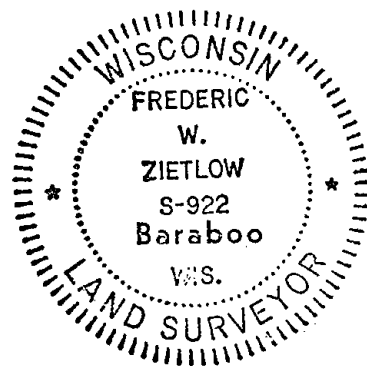

CERTIFIED CORRECT:

Frederic W. Zietlow

Registered Land Surveyor

DATE: DECEMBER 30, 1976

BASIS FOR MONUMENT LOCATION

(Use reverse side if necessary)

Show info such as: History of corner, with reference to Vol. and pg, dates, surveyor; exact description of monument replaced; if location computed, by taped or EDM traverse; landowner remarks, etc.

CHECKED ADAMS COUNTY SURVEY RECORDS AND FOUND THAT M.C. SMITH SET OUT 2 BEARING TREES IN 1921. MADE A THOROUGH SEARCH AND FOUND NO EVIDENCE OF THEM. FOUND A 4" CEDAR POST SET BY NEKOOSA-EDWARDS PAPER CO. AND ACCEPTED AS CORNER. FIT EDM TRAVERSE OF SECTION EXCELLENT MON. & TIES OK 10-21-85 SS.

ALL OK 8-24-90 SS

ALL OK 1-6-95 JG-BS

" " 1-6-00 SJS

ALL OK 2-21-03 JG-DA

1 NEW TIE 1-03-11 SS

TIE SKETCH

(Show at least four ties)

