# 05 ADAMS COUNTY COUNTY CORNER NO: 75 ROMPORTOL ID: 41705192000

## PUBLIC LAND SURVEY MONUMENT RECORD

TYPE OF MONUMENT:

**HARRISON** 

ADAMS COUNTY COORDINATES, NAD 83 (2007)

N. 205231.730

E. 499450.608

**ELEVATION-**

DATUM


FIELD WORK DATE:

02/19/2019


#### BASIS FOR MONUMENT LOCATION

1975 - PLS-1103 RAN EDM/TRANSIT TRAVERSE OF THE ENTIRE AREA. SET CORNER BY DOUBLING OVER LINE FROM CENTER OF SECTION AND 40 CORNER TO THE EAST. THESE CORNERS ARE EXISTING CONCRETE MONUMENTS.

2019 - PLS-2675 FOUND HARRISON MONUMENT 3" BELOW THE ROAD SURFACE, 2 TIES, AND 2 WITNESSES. THE MONUMENT FIT WITH THE SW TIE AND BOTH WITNESSES. ACCEPTED THE HARRISON MONUMENT AS THE CORNER. MEASURED TO THE 2 RIGHT OF WAY IRONS, MEASURED TO THE EXISTING TIES, AND WITNESS.

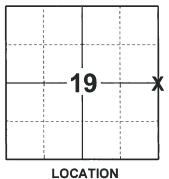

(INDICATE CORNER BY "X")

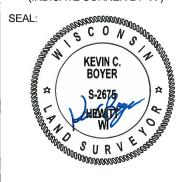

DATA SHOWN HERE ON THIS TIE SHEET IS CORRECT AND COMPLETE TO THE BEST OF MY KNOWLEDGE AND BELIEF.


PROFESSIONAL LAND SURVEYOR

#### - TIE SKETCH

NOTE: THE CORNER LANDS ±7' SOUTH OF DOVER DRIVE AND ±34' WEST OF CTH "Z".



- O FOUND 3/4" IRON ROD
- FOUND HARRISON MONUMENT
- WITNESS POWERPOLE
- RIGHT-OF-WAY GUARD POST

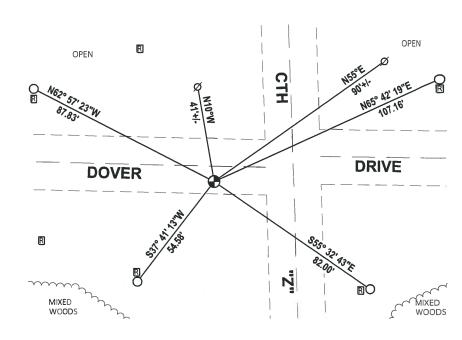

### CORNER NO. ADAMS COUNTY 20 **SECTION** Survey Monument Record 17 TOWN TYPE OF MONUMENT: Harrison Monument RANGE STATE PLANE COORDINATES: N\_ ELEVATION - M.S.L. DATUM: \_\_ THETA ANGLE: \_\_\_ \_\_ PAGE -FIELD BOOK: ..... BASIS FOR MONUMENT LOCATION (Use reverse side if necessary) LOCATION Show info such as: History of corner, with reference to Vol. and pg, dates, surveyor; exact description of monument replaced; if location computed, by taped or EDM traverse; landowner (Indicated by 'X') SEAL: remarks, etc. Ran EDM/transit traverse of the entire area. Set corner by doubling over line from center of section and 40 corner to the east. These corners are existing concrete monuments. MON + TIES OK BS-K/ 9/39/80 5/30/85 DK. 2-GONE, 1-NEW 6-25-90 JG Z 6 ONE 3 NEW 8-24-94 JG-55 TIES OK, Z-7-00, JG-SS 2. GONE 2-NEW 2-15-05 JG-DA 2 NEW TIES-12-17-10 SS Registered DATE: 84 Kin Carlson "JALK PIVE TIE SKETCH (Show at least four ties) NEW PX (بينج) ، OH GONE ao' Dr. NOTE: Ties in trees to nail in disc. 87 . FO 3/4 ROD Fo 3/4 Ro N.E. COR

TOP TIMBER OF CARLSON, DOUER SHARES SIGN

REVISED 1974