


Government Land Corner Certificate

ADAMS County
 TYPE OF MONUMENT: 2" IRON PIPE / ALUM. CAP ~~60 P. SPIRE (FENCE)~~
 STATE PLANE COORDINATES: N _____
 E _____
 ELEVATION — M.S.L. DATUM: _____
 THETA ANGLE: _____
 FIELD BOOK: 76 PAGE 59
 DRAWN BY: LANCE J. HABECK

CORNER NO. 82 M.L.
 SECTION 19
 TOWN 17
 RANGE 5

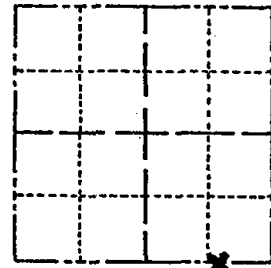

LOCATION MEANDER CORNER
(Indicated by 'X')


BASIS FOR MONUMENT LOCATION

Show info such as: History of corner, with reference to Vol. and pg., dates, surveyor; exact description of monument replaced; if location computed, by taped or EDM traverse; landowner remarks, etc. (Use reverse side if necessary)

This corner was set on an existing fence which is a well established possession line. No other location could be justified for this Meander Corner.

ALL OK 1-30-90 KZ-SS
 ALL OK 8-24-94 JG-SS
 TIES OK 2-7-00, JG-SS
 OK 2-14-05 DA/JG
 OK 9-2-10 SS

SEAL:

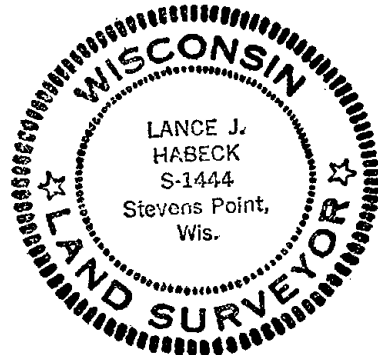

DATA SHOWN HERE ON CERTIFIED CORRECT:

Lance J. Habeck
Registered Land Surveyor

DATE: 2/4/81

TIE SKETCH

Show at least four ties, also fence lines, roads, topo, size and type of witness trees and if off road - best way to arrive at corner.

