

21 SECTION 17 TOWN 05 RANGE

ADAMS COUNTY

COUNTY CORNER NO: 86
ROMPORTOL ID: 41705210020

PUBLIC LAND SURVEY MONUMENT RECORD

TYPE OF MONUMENT: HARRISON
ADAMS COUNTY COORDINATES, NAD 83 (2007)

N. 202717.227
E. 507347.523


ELEVATION- - - - DATUM - - - -

FIELD WORK DATE: 01/17/2019

BASIS FOR MONUMENT LOCATION

1979 - PLS-1478 SET HARRISON EQUIDISTANT AND ON LINE BETWEEN ADJACENT SECTION CORNERS. EXCAVATION WAS NOT MADE AT THIS POINT DUE TO LACK OF COLLATERAL EVIDENCE IN THE AREA.


2019 - PLS-2675 FOUND HARRISON MONUMENT 4" BELOW THE ROAD SURFACE, 1 WITNESS, AND 1 PROPERTY IRON. THE MONUMENT AGREES WITH THE 1 WITNESS. ACCEPTED THE HARRISON MONUMENT AS THE CORNER LOCATION. SET 3 NEW TIES AND MEASURED TO TIES, WITNESS, AND PROPERTY IRON.

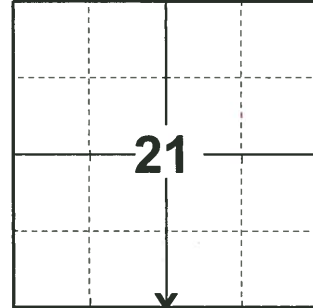

LOCATION

(INDICATE CORNER BY "X")

SEAL:

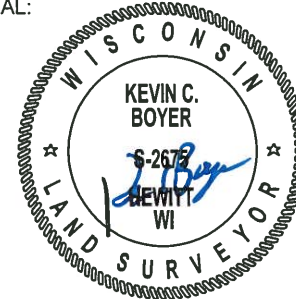


DATA SHOWN HERE ON THIS TIE SHEET IS CORRECT AND COMPLETE TO THE BEST OF MY KNOWLEDGE AND BELIEF.

PROFESSIONAL LAND SURVEYOR

DATE 3/12/19

- TIE SKETCH

NOTE: THE CORNER FALLS 2.1'± SOUTH OF CTH "F" CENTERLINE.

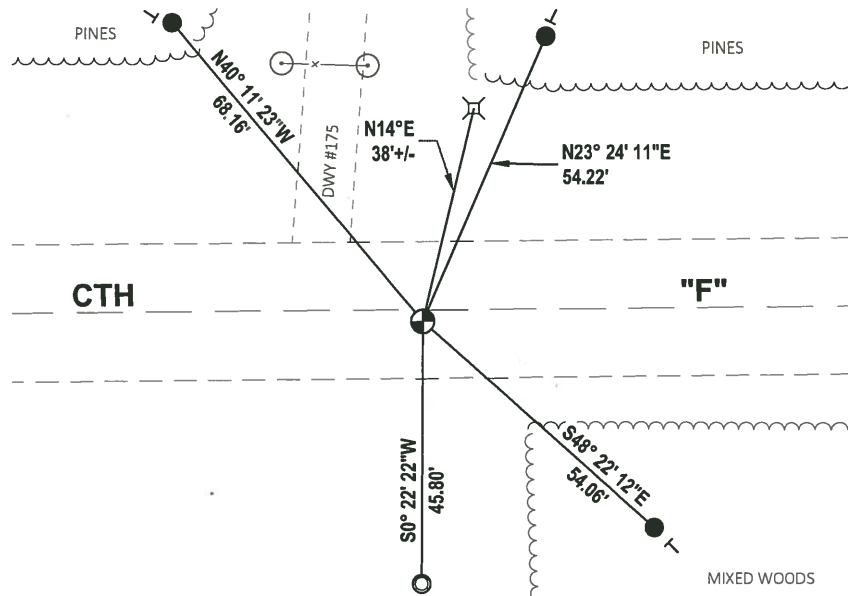


- SET 3/4" x 18" IRON REBAR, 1.50#/FT
- FOUND 2-3/8" O.D. IRON PIPE
- ⊕ FOUND HARRISON MONUMENT
- ⊖ VINYL "T" POST
- ⊗ SW COR OF TEL. PEDESTAL

Government Land Corner Certificate

ADAMS County

CORNER NO. 36 86
 SECTION 28
 TOWN 17
 RANGE 5

TYPE OF MONUMENT: Harrison Standard
 STATE PLANE COORDINATES: N _____
 E _____
 ELEVATION — M.S.L. DATUM: _____
 THETA ANGLE: _____
 FIELD BOOK: 54 PAGE 52
 DRAWN BY: G. Rhinehart

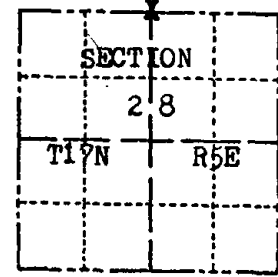

LOCATION
(Indicated by 'X')

BASIS FOR MONUMENT LOCATION

Show info such as: History of corner, with reference to Vol. and pg., dates, surveyor; exact description of monument replaced; if location computed, by taped or EDM traverse; landowner remarks, etc. (Use reverse side if necessary)

Set equidistant and on line between adjacent section corners.

Excavation was not made at this point due to lack of collateral evidence in the area.

SEAL:




DATA SHOWN HERE ON CERTIFIED CORRECT:

Gregory P. Rhinehart
 Registered Land Surveyor

DATE: 4-30-79

TIE SKETCH

Show at least four ties, also fence lines, roads, topo, size and type of witness trees and if off road - best way to arrive at corner.

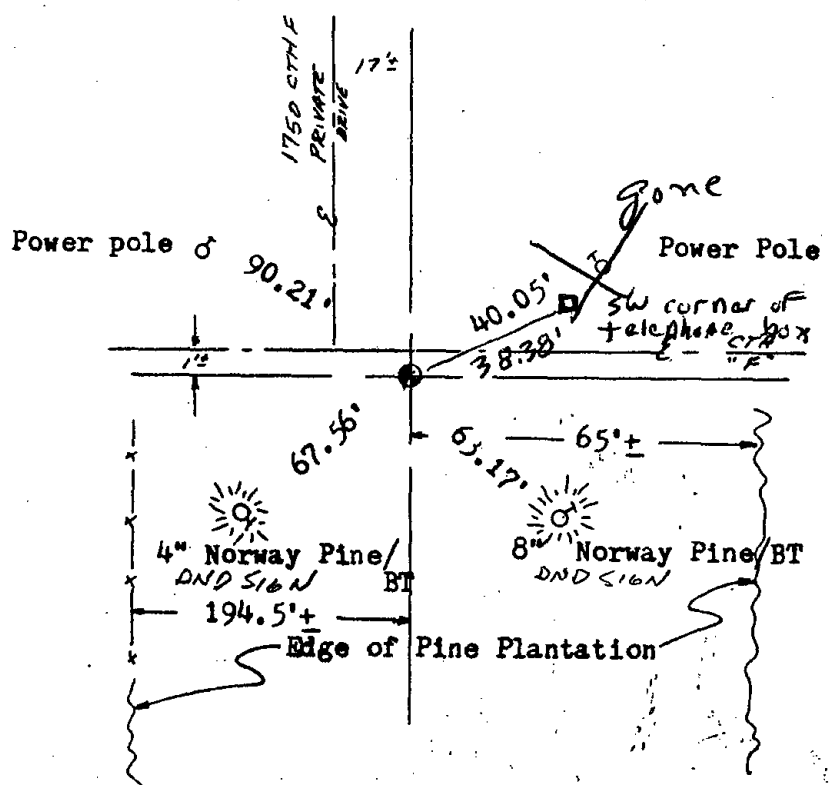


MAINTENANCE RECORD

| Date | Init. | Remarks |
|------------|-------|----------------|
| 8/2-180 | RN-TH | MON OK |
| 6-7-95 | MC | New tie |
| 2-7-00 | JG-SS | TIES OK |
| 2-15-05 | DA/SB | OK ADDED SIGNS |
| 11/21/2010 | GR-SS | OK |

Government Land Corner Certificate

ADAMS County
 TYPE OF MONUMENT: Harrison Standard
 STATE PLANE COORDINATES: N _____
 E _____
 ELEVATION — M.S.L. DATUM: _____
 THETA ANGLE: _____
 FIELD BOOK: 54 PAGE 52
 DRAWN BY: G. Rhinehart

CORNER NO. 86 ⁸⁶
 SECTION 28
 TOWN 17
 RANGE 5

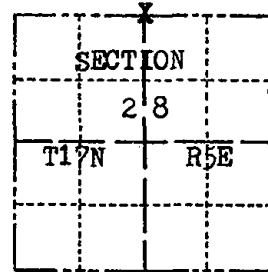

LOCATION
(Indicated by 'X')

BASIS FOR MONUMENT LOCATION

Show info such as: History of corner, with reference to Vol. and pg., dates, surveyor; exact description of monument replaced; if location computed, by taped or EDM traverse; landowner remarks, etc. (Use reverse side if necessary)

Set equidistant and on line between adjacent section corners.

Excavation was not made at this point due to lack of collateral evidence in the area.

*1 Gone no new 5/28/85 D.K.
 ALL OK 6-20-90 JG
 ALL OK 1-4-95 JG-BB*

SEAL:




DATA SHOWN HERE ON
CERTIFIED CORRECT:

Gregory P Rhinehart
Registered Land Surveyor

DATE: 4-30-79

TIE SKETCH

Show at least four ties, also fence lines, roads, topo, size and type of witness trees' and if off road - best way to arrive at corner.

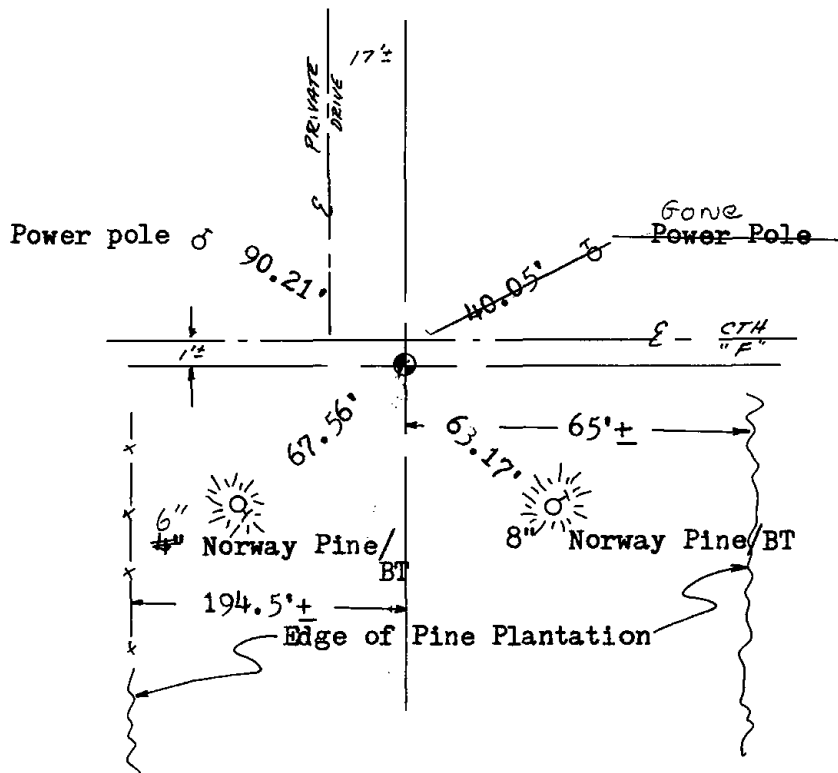

MAINTENANCE RECORD

| Date | Init. | Remarks |
|---------|-------|---------|
| 8/27/80 | RN-TH | MON OK |
| | | |
| | | |
| | | |
| | | |