# 05 ADAMS COUNTY COUNTY CORNER NO: 87 ROMPORTOL ID: 41705210000

## PUBLIC LAND SURVEY MONUMENT RECORD

**HARRISON** TYPE OF MONUMENT:\_ ADAMS COUNTY COORDINATES, NAD 83 (2007) N. 202720.866 E. 509978.850 **ELEVATION-**DATUM 01/17/2019 FIELD WORK DATE:


#### BASIS FOR MONUMENT LOCATION

1979 - PLS-1478 CORNER WAS SET ON THE CENTERLINE OF CTH F AT THE FENCE LINES TO THE NORTH AND SOUTH. EXCAVATION AT THIS POINT WAS NOT MADE DUE TO THE LARGE CUT IN THIS AREA. THE PROPORTIONATE METHOD OF SETTING A CORNER WOULD HAVE CAUSED AN ENCROACHMENT OF THE BUILDINGS TO THE SOUTH IN SECTION 27, SET HARRISON MONUMENT AND TIED OUT.

2019 - PLS-2675 FOUND HARRISON MONUMENT 4" BELOW THE ROAD SURFACE, 1 TIE, 1 WITNESS, AND 2 PROPERTY IRONS. THE MONUMENT AGREES WITH THE TIE AND WITNESS. ACCEPTED THE HARRISON MONUMENT AS THE CORNER LOCATION. SET 2 NEW TIES. MEASURED TO THE TIES, WITNESS, AND THE PROPERTY IRONS.



(INDICATE CORNER BY "X")

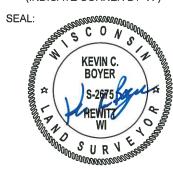

DATA SHOWN HERE ON THIS TIE SHEET IS CORRECT AND COMPLETE TO THE BEST OF MY KNOWLEDGE AND BELIEF


PROFESSIONAL LAND SURVEYOR

#### -TIE SKETCH

NOTE: THE CORNER FALLS 0.5'± SOUTH OF CENTERLINE OF CTH "F".



- SET 3/4" x 18" IRON REBAR, 1.50#/FT
- O FOUND 3/4" IRON ROD
- FOUND HARRISON MONUMENT
- STEEL FENCE POST
- VINYL "T" POST
- WITNESS TREE

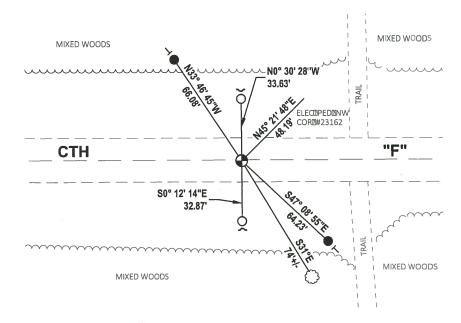

## **Government Land Corner Certificate**

ADAMS		Count	t.v	
TYPE OF MONUMENT: _	Harrison			
STATE PLANE COORDINAT	ΓES: N			
	<u>E</u>			_
ELEVATION - M.S.L. DA	TUM:			
THETA ANGLE:				_
FIELD BOOK:54		_ PAGE	51	_
DRAWN BY: G. Rhinel	oart			
<del>-</del>				

## BASIS FOR MONUMENT LOCATION

Show info such as: History of corner, with reference to Vol. and pg., dates, surveyor; exact description of monument replaced; if location computed, by taped or EDM traverse; landowner remarks, etc. (Use reverse side if necessary)

This corner was set on the centerline of CTH "F" at the fence lines to the north and south. Excavation at this point was not made due to the large cut in this area. the proportionate method of setting a corner would have caused an encroachment of the buildings to the south in section 27. ALL OK 5/28/85 D.K.

ALL OK 6-20-90 JG ALL OK 1/4/95 J6-BS 2-60NE, 2-NEW TIES, 2-7-00, J6-55 ALLOK, 2-15-05, DA-JG

CORNER NO. . 27 SECTION 17 TOWN 5 RANGE





DATA SHOWN HERE ON CERTIFIED CORRECT:

Registered Land Surveyor

NW COR

in lawn- no BT

4-30-79 DATE:

## TIE SKETCH

Show at least four ties, also fence lines, roads, topo, size and type of witness trees' and if off road - best way to arrive at corner.

#### MAINTENANCE RECORD

Date	Init.	Remarks
8/27/80	RN-TH	MON OK
11-22-10	GR SS	INEW

ELEC BOX SP23162 GONE 2016 2010 Power Pole Burr Oak/BT CEDAR 8 WORWAY #540°E Pine/ BT Burr Oak