30 SECTION 17

ADAMS COUNTY COUNTY CORNER NO: 95 ROMPORTOL ID: 41705302000

IC LAND SURVEY MONUMENT RECORD

HARRISON (BROKEN-TOP) TYPE OF MONUMENT:

ADAMS COUNTY COORDINATES, NAD 83 (2007)

N. 199940.646

E. 499436.114


DATUM_ **ELEVATION-**

02/21/2019 FIELD WORK DATE:


BASIS FOR MONUMENT LOCATION

1975 - PLS-976 FOUND BRASS TABLET IN CONCRETE MONUMENT AS CALLED BY R.K. SAYLER, L.S. 9/6/73. TIED EXISTING MONUMENT, REMOVED SAME AND REPLACED WITH HARRISON STD. MONUMENT.

2019 - PLS-2675 FOUND HARRISON MONUMENT (BROKEN-TOP) 12" BELOW THE GROUND, AND 3 WITNESSES. THE MONUMENT AGREES WITH THE WITNESSES. ACCEPTED THE HARRISON MONUMENT (BROKEN-TOP) AS THE CORNER. SET 2 NEW TIES. MEASURED TO 2 FOUND PROPERTY IRONS AND WITNESSES.

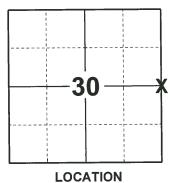

(INDICATE CORNER BY "X")

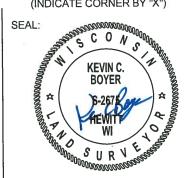

DATA SHOWN HERE ON THIS TIE SHEET IS CORRECT AND COMPLETE TO THE BEST OF MY KNOWLEDGE AND BELIEF.


PROFESSIONAL LAND SURVEYOR

- TIE SKETCH

NOTE: THE CORNER LANDS 30'± EAST OF CENTERLINE OF CTH "Z" AND 13'± SOUTH OF CENTERLINE OF VANTHEL RD.



- SET 3/4" x 18" IRON REBAR, 1.50#/FT
- FOUND 3/4" IRON ROD
- FOUND 2-3/8" O.D. IRON PIPE
- FOUND HARRISON MONUMENT (BROKEN-TOP)
- WITNESS LIGHT POLE
- STEEL FENCE POST
- VINYL "T" POST
- TELEPHONE PEDESTAL

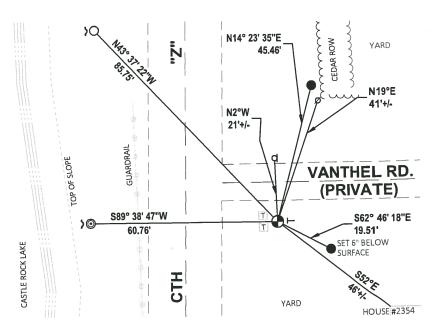

ADAMS COUNTY

Survey Monument Record

TYPE OF MONUMENT: HAKKISON STD STATE PLANE COORDINATES: N. ELEVATION - M.S.L. DATUM: _ THETA ANGLE: . FIELD BOOK: __LL. _ PAGE

BASIS FOR MONUMENT LOCATION


(Use reverse side if necessary)


Show info such as: History of corner, with reference to Vol. and pg, dates, surveyor; exact description of monument replaced; if location computed, by taped or EDM traverse; landowner

FOUND BRASS TABLET IN CONC. MONUMENT AS CAUGO BY R.K. SAYLER, LIS. 9/6/73. THEO EXISTING MONUMENT, REMOVED SAME ¿ REPLACED WITH HARRISON STO. MONUMENT

MON OK 4/8/80 BS-SS ALL OK 5/30/85 D.K. ALL OK 6-25-90 JG 2-NEW 8-24-94 JG-55 ALL OK 3-28-00 JG-MIT. OK 2-14-05 DA/JG

CORNER NO. SECTION 17N TOWN 5 E RANGE

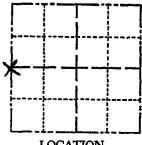

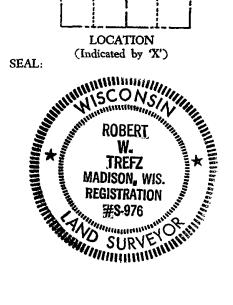

CERTIFIED CORRECT: Registered Land Surveyor DATE: 10/20/75

MADISON, WI 53705

