

29 SECTION 17 TOWN 05 RANGE

ADAMS COUNTY

COUNTY CORNER NO: 105
ROMPORTOL ID: 41705290000

PUBLIC LAND SURVEY MONUMENT RECORD

TYPE OF MONUMENT: HARRISON
ADAMS COUNTY COORDINATES, NAD 83 (2007)

N. 197440.426

E. 504661.107


ELEVATION- _____ DATUM _____

FIELD WORK DATE: 01/31/2019

BASIS FOR MONUMENT LOCATION

1971 - PLS-981 FOUND "RR" SPIKE AND SET HARRISON MONUMENT.

2019 - PLS-2675 FOUND HARRISON MONUMENT 2" BELOW THE ROAD SURFACE AND 1 WITNESS. THE MONUMENT AGREES WITH THE EXISTING WITNESS. ACCEPTED THE HARRISON MONUMENT AS THE CORNER. SET 4 NEW TIES AND MEASURE TO THE EXISTING WITNESS.

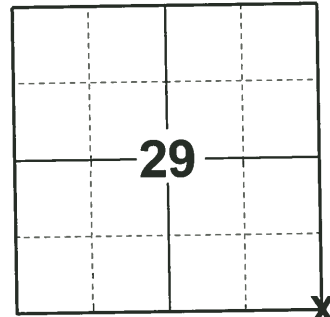

LOCATION
(INDICATE CORNER BY "X")

SEAL:




DATA SHOWN HERE ON THIS TIE SHEET IS CORRECT AND COMPLETE TO THE BEST OF MY KNOWLEDGE AND BELIEF.

PROFESSIONAL LAND SURVEYOR


DATE 3/12/19

- TIE SKETCH -

NOTE: THE CORNER LANDS 1± WEST OF CENTERLINE OF 18TH AVE AND 2± NORTH OF CENTERLINE OF DYKE AVE.

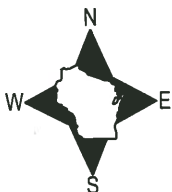

- SET 3/4" x 18" IRON REBAR, 1.50#/FT
- ⊕ FOUND HARRISON MONUMENT
- ∅ WITNESS POWER POLE
- | VINYL "T" POST

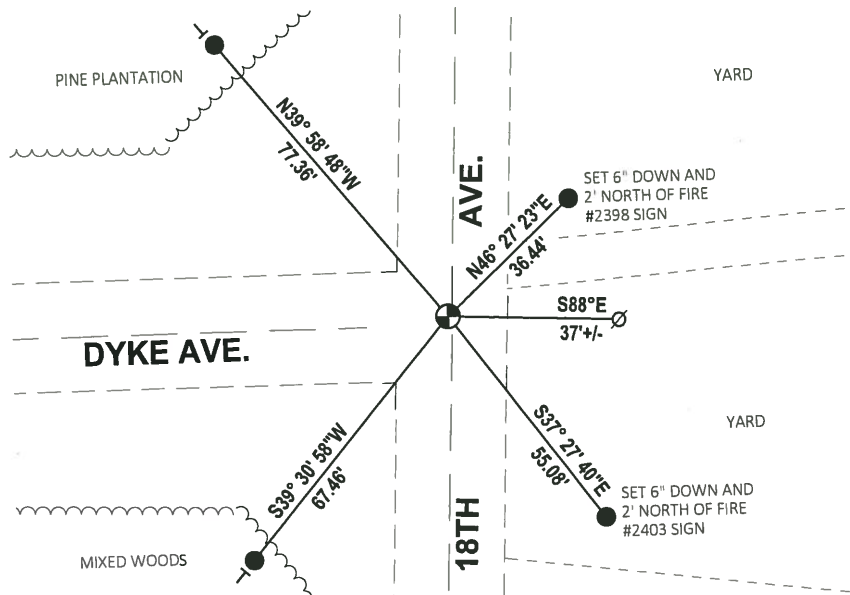

ADAMS COUNTY

Survey Monument Record

TYPE OF MONUMENT: 30" HARRISON

STATE PLANE COORDINATES: N _____
E _____

ELEVATION — M.S.L. DATUM: _____

THETA ANGLE: _____


FIELD BOOK: 104 PAGE 62

CORNER NO. 30

SECTION 29

TOWN 17

RANGE 5

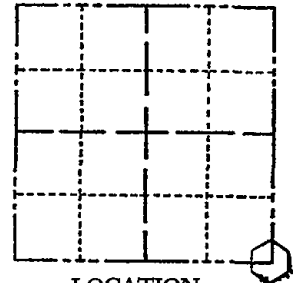

LOCATION
(Indicated by 'X')

SEAL:

BASIS FOR MONUMENT LOCATION

(Use reverse side if necessary)

Show info such as: History of corner, with reference to Vol. and pg, dates, surveyor; exact description of monument replaced; if location computed, by taped or EDM traverse; landowner remarks, etc.

Found "RR" spike and set monument

July 28, 1971

Sam T. Mullen R.L.S. S-981


CORNER O.K. 10/30/75 D.M. - S.S.
 COR OK 4/8/80 BS-SS
 ALL OK 5/23/85 D.K.
 1-GONE, 1-NEW 6-25-90 JG
 ALL OK 8-29-94 JG-SS

CERTIFIED CORRECT:

Registered Land Surveyor

DATE: _____

TIE SKETCH OK 2-14-00 SS
 1 GONE, 1 NEW 2-14-05 JG/OA
 (Show at least four ties) 3 GOOD TIES REMAIN 8-24-10 SS
 GONE 1990

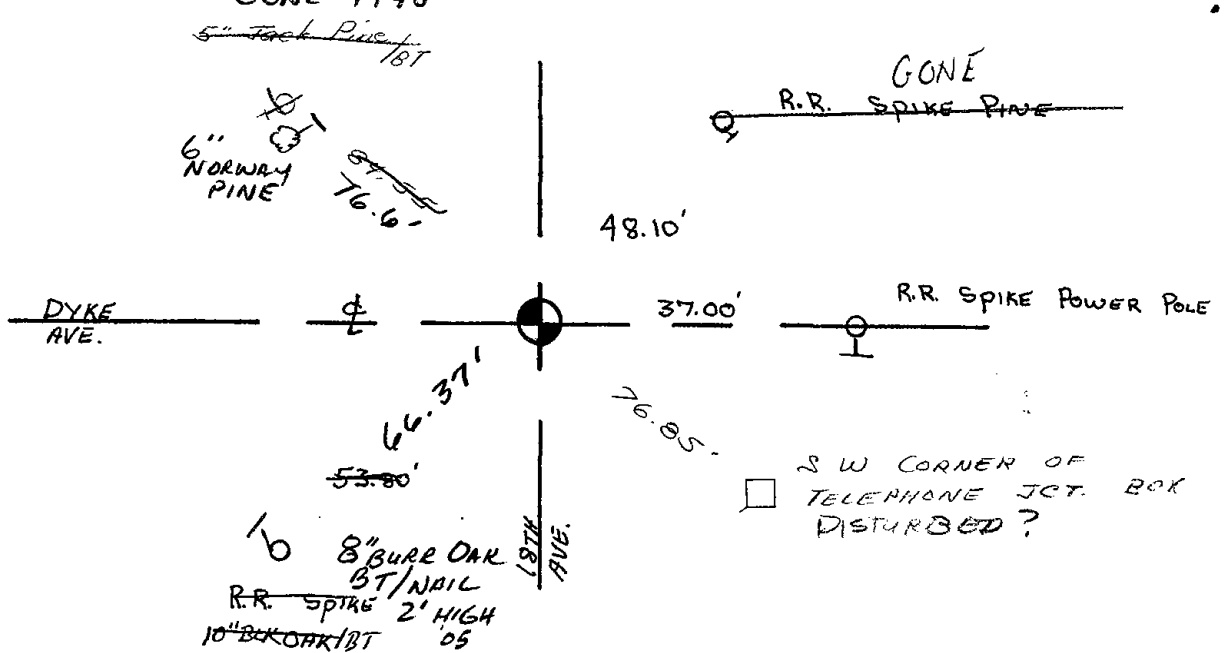

SW CORNER OF
 TELEPHONE JCT. BOX
 DISTURBED?