26 SECTION

OS RANGE ADAMS COUNTY COUNTY CORNER NO: 110

ROMPORTOL ID: 41705260020

PUBLIC LAND SURVEY MONUMENT RECORD

HARRISON TYPE OF MONUMENT: ADAMS COUNTY COORDINATES, NAD 83 (2007)

N. **197550.407**

E. 517879.283


ELEVATION-DATUM

01/10/2019 FIELD WORK DATE:

BASIS FOR MONUMENT LOCATION

1976 - PLS 922-SEARCHED IN FIELD FOR EVIDENCE OF COUNTY SURVEYOR HUGH HURLEY'S CORNER AND BEARING TREES FROM 1904. ALL EVIDENCE IS OBLITERATED. THIS CORNER WAS SET EQUIDISTANT ON LINE BETWEEN THE NE AND NW CORNERS. (SINGLE PROPORTION METHOD VIA E.D.M TRAVERSE)

2019 - PLS-2675 FOUND HARRISON MONUMENT FLUSH WITH THE GROUND AND 2 WITNESS TREES. THE MONUMENT AGREES WITH THE WITNESS TREES. ACCEPTED THE HARRISON MONUMENT AS THE CORNER. SET 4 NEW TIES AND MEASURED TO THE EXISTING WITNESS TREES.

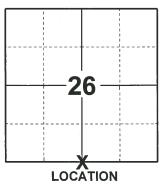

(INDICATE CORNER BY "X")



DATA SHOWN HERE ON THIS TIE SHEET IS CORRECT AND COMPLETE TO THE BEST OF MY KNOWLEDGE AND BELIEF.

PROFESSIONAL LAND SURVEYOR

-TIE SKETCH -

NOTE: THE CORNER LANDS 3.5'± SOUTH OF FENCE.




SET 3/4" x 18" IRON REBAR, 1.50#/FT

FOUND HARRISON MONUMENT

VINYL "T" POST

WITNESS TREE

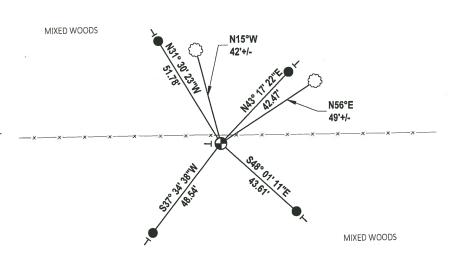

ADAMS COUNTY

Survey Monument Record

TYPE OF MONUMENT: 30" HARRISON MONUMENT STATE PLANE COORDINATES: N 43° 54' 31.1 E 089°52' 03.6

ELEVATION - M.S.L. DATUM: _

THETA ANGLE: ____

FIELD BOOK: ___ _ PAGE

CORNER NO. SECTION 17.N TOWN SE RANGE

BASIS FOR MONUMENT LOCATION

(Use reverse side if necessary)

Show info such as: History of corner, with reference to Vol. and pg, dates, surveyor; exact description of monument replaced; if location computed, by taped or EDM traverse; landowner remarks, etc.

SEARCHED IN FIELD FOR EVIDENCE

OF COUNTY SURVEYOR HUGH HURLEY'S CORNER & BEARING TREES FROM 1964. ALL EVIDENCE IS OBLITERATED. THIS CORNER WAS SET EQUA-DISTANT ON LINE BETWEEN THE HE & NW CORS. (SINGLE PROPORTION METHOD VIA EDM. TRAVERSE)

1 NEW TIE 10.24-85 M.B.

ALL OK 2-5-90 55 11-29-10 GR 2 NOW TIES

FREDERIC w. ZIETLOW S-922 Baraboo

LOCATION (Indicated by 'X')

SEAL:

CERTIFIED CORRECT:

Registered Land Surveyor

FEBRUARY DATE: .

TIE SKETCH

(Show at least four ties)

ALL TIES P.K. NAIL WITH SHINER, BLAZES
5' + ABOVE GROUND, FENCE LINES ARE NEW,
[NSCRIBED "BT."

