SECTION

OB ADAMS COUNTY

COUNTY CORNER NO: 20

ROMPORTOL ID: 41706012000


PUBLIC LAND SURVEY MONUMENT RECORD

TYPE OF MONUMENT: ADAMS COUNTY COORDINATE	HARRISON S, NAD 83 (2007)
N. 221644.459	
E. <u>557362.151</u>	
ELEVATION	DATUM
FIELD WORK DATE: 12/05	5/2017


BASIS FOR MONUMENT LOCATION

1974 - PLS 878 CALCULATED POINT ESTABLISHED BY TRAVERSING THE ENTIRE SECTION AND TAKING INTO ACCOUNT VARIOUS SURVEYS IN THE AREA. THE PERRY-CARRINGTON SURVEY IN THE SOUTHWEST QUARTER OF THE SECTION APPEARED TO BE THE MOST NEARLY CORRECT. SET A HARRISON MONUMENT AT THE CALCULATED LOCATION AND TIED OUT.

2017 - PLS 2994 FOUND A HARRISON MONUMENT FLUSH WITH THE GROUND SURFACE AND 2 WITNESS TREES. THE MONUMENT AGREES WITH THE EXISTING WITNESS TREES. ACCEPTED THE HARRISON MONUMENT AS THE CORNER LOCATION. SET 4 NEW TIES AND MEASURED TO THE TIES AND WITNESS TREES.

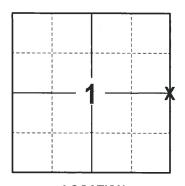

LOCATION (INDICATE CORNER BY "X")

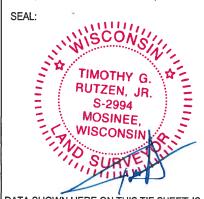

DATA SHOWN HERE ON THIS TIE SHEET IS CORRECT AND COMPLETE TO THE BEST OF MY KNOWLEDGE AND BELIEF.

PROFESSIONAL LAND SURVEYOR


DATE

- TIE SKETCH

NOTE: THE CORNER FALLS 6'± NORTH OF THE FENCE LINE.



3/4" x 18" IRON REBAR SET, 1.50#/FT HARRISON FOUND STEEL FENCE POST VINYL "T" POST WITNESS TREE FOUND

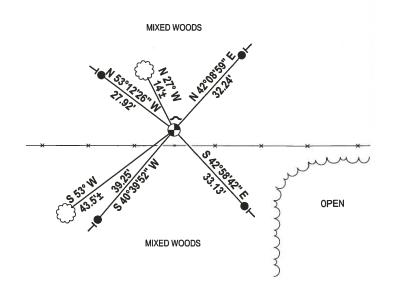

ADAMS COUNTY

Survey Monument Record

TYPE OF MONUMENT: Harrison Standard
STATE PLANE COORDINATES: N

E_____

ELEVATION — M.S.L. DATUM: _____

FIELD BOOK: PAGE

BASIS FOR MONUMENT LOCATION

(Use reverse side if necessary)

Show info such as: History of corner, with reference to Vol. and pg, dates, surveyor; exact description of monument replaced; if location computed, by taped or EDM traverse; landowner remarks, etc.

This point established by traversing entire section and taking into account various surveys in the area. The Perry-Carrington survey in the Southwest Quarter of the section appeared to be the most nearly correct. This point monumented to fit that survey.

CORNER NO. 401

SECTION

TOWN

RANGE

LOCATION
(Indicated by 'X')

SEAL:

os 7" Black Oak /BT

CORNER 9.20-75 CERTIFIED CORRECT: 1/23/80 OK hohow B. Kach ALL OK 7-12-85 Registered Land Surveyor SS-DK DATE: June 14, 1974 ALL OK 1-31-90 KZ-6R ALL OK 7-29-94 56-BS 1-GONE, 3-14-65 - JG-DA TIE SKETCH Ties to nail and disc. (Show at least four ties) I-NEW TIE 2-10-00, JG-BZ
I NEW TIE Z-4-10 SS 7" Poplar /BT 8" Poplar 18T (Bark scribed) ubis and

W. PINE

REVISED 1972