

PUBLIC LAND SURVEY MONUMENT RECORD

TYPE OF MONUMENT: CHISELED "X"
 ADAMS COUNTY COORDINATES, NAD 83 (2007)

N. 218825.293

E. 530958.483


ELEVATION- _____ DATUM _____

FIELD WORK DATE: 06/13/2017

BASIS FOR MONUMENT LOCATION

1972- PLS 878 FOUND NAIL AND VERIFIED AS SECTION CORNER BY RETRACEMENT OF ADJOINING PLATTED SUBDIVISIONS.

2017 - PLS 2994 FOUND CHISELED "X" ON ROAD SURFACE AND 4 WITNESSES. THE MONUMENT AGREES WITH THE EXISTING WITNESSES. ACCEPTED CHISELED "X" AS CORNER LOCATION, SET 2 NEW TIES, FOUND 2 WISDOT RIGHT OF WAY MONUMENTS FOR THE OTHER TIES, RE-MEASURED TO ALL TIES.

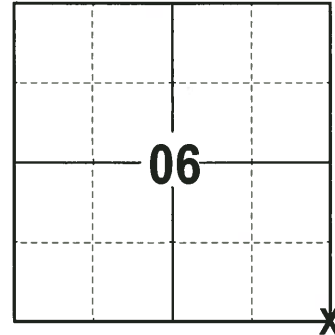

LOCATION
 (INDICATE CORNER BY "X")

SEAL:





DATA SHOWN HERE ON THIS TIE SHEET IS CORRECT AND COMPLETE TO THE BEST OF MY KNOWLEDGE AND BELIEF.

PROFESSIONAL LAND SURVEYOR

DATE 6/26/17

- TIE SKETCH -

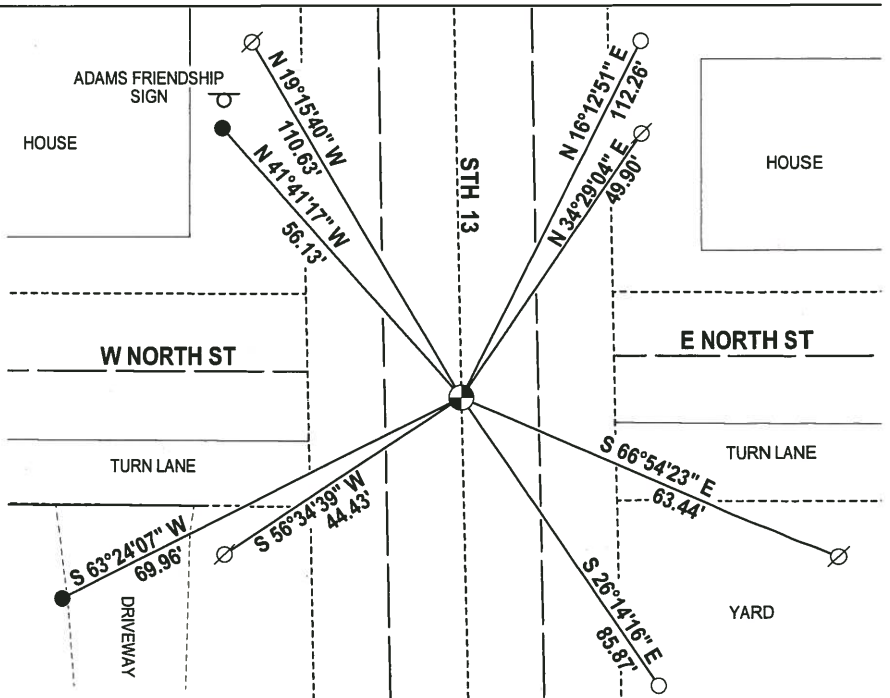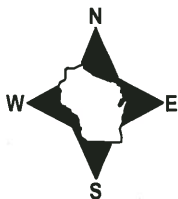

- 3/4" x 18" IRON REBAR SET, 1.50#/FT
- 3/4" IRON ROD W/WISDOT CAP FOUND
- ⊙ CHISELED "X" FOUND
- ⊘ WITNESS POWER POLE FOUND

ADAMS COUNTY

Survey Monument Record

CORNER NO. 168
SECTION 6
TOWN 17
RANGE 6


TYPE OF MONUMENT: ~~30" IRON~~ NAIL *CHISEL CROSS CENTERLINE*

STATE PLANE COORDINATES: N _____
E _____

ELEVATION — M.S.L. DATUM: _____


THETA ANGLE: _____

FIELD BOOK: 106? PAGE ?

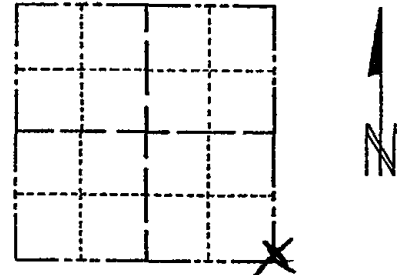

LOCATION
(Indicated by 'X')

SEAL:

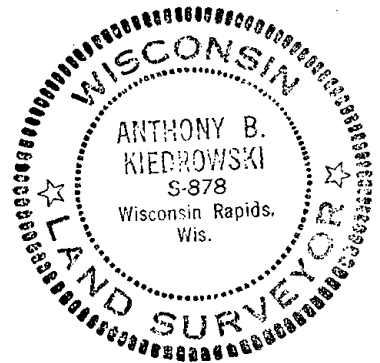

BASIS FOR MONUMENT LOCATION

(Use reverse side if necessary)

Show info such as: History of corner, with reference to Vol. and pg, dates, surveyor; exact description of monument replaced; if location computed, by taped or EDM traverse; landowner remarks, etc.

Found nail and ~~monument~~

August 1, 1972

Anthony B. Kiedrowski R.L.S. 878

Location of nail verified as section corner by retracement of adjoining platted subdivisions. Could not install monument at this time because of concrete pavement.

*Everything o.k. 11/12/75 DM-SS
OK 1128180 RN-SS
" 7126185 DK
OK 2-6-90 KZ-CR*

CERTIFIED CORRECT:

Anthony B. Kiedrowski
Registered Land Surveyor

NEW POWER POLES AND NEW DISTANCES 7/27/94 JG-BS DATE: _____

TIE SKETCH *1-GONE, 1-NEW TIE, 2-10-00, JG-BZ
OK, 1-25-05-JG*
(Show at least four ties)

