05 **SECTION**

ADAMS COUNTY

COUNTY CORNER NO: 25

ROMPORTOL ID: 41706050000

AIRPORT


PUBLIC LAND SURVEY MONIMENT RECORD

I OBLIC LA	IND SOLVET	IVIOIVIOIVI	LIVITILLOND
TYPE OF MONUMENT: ADAMS COUNTY COORDINATES, NAD 83	HARRISON 3 (2007)		
N. 218843.474	•		
E. <u>536259.915</u>			
ELEVATION DATUM			
FIELD WORK DATE: 06/07/2017			0,5
BASIS FOR MONUMENT LOCAT	<u>TION</u>		
1978 - PLS 878 FOUND NO SURVEY RECORDS. LOCATION AND FOUND 8"X10"X39" SANDSTON A CROSS CUT. LOWERED STONE AND SET HA	IE 15" DOWN WITH A HOLE DR		X
1997 - PLS (UNKNOWN) FOUND HARRISON MO SET 3 NEW TIES.	NUMENT AND 1 PROPERTY IR	ON USED AS TIE.	LOCATION (INDICATE CORNER BY "X")
2017 - PLS 2994 FOUND HARRISON MONUMEN MONUMENT AGREES WITH THE EXISTING TIES SET 1 NEW TIE AND RE-MEASURED TO EXISTI	S. ACCEPTED HARRISON AS C		TIMOTHY G. RUTZEN, JR. S-2994 MOSINEI, WISCONDIN WISCONDIN DATA SHOWN HERE ON THIS TIE SHEET IS CORRECT AND COMPLETE TO THE BEST OF M KNOWLEDGE AND BELIEF. PROFESSIONAL LAND SURVEYOR DATE
- TIE SKETCH NOTE: THE CORNER FALLS 2'± SOUTH OF THE CENTERLINE OF E NORTH ST & DEERBORN AVE, AND 3'± WEST OF THE CENTERLINE OF 11TH AVE.	YARD FOOD,	11TH AVE	FIELD
N	<u>E NORTH ST</u>		DEERBORN AVE
W		11ТН А	\$ 71°32'16" E

- 3/4" x 18" IRON REBAR SET, 1.50#/FT 3/4" IRON ROD FOUND
- ⊕ 1-1/4" O.D. IRON PIPE FOUND→ HARRISON FOUND
- VINYL "T" POST

Government Land Corner Certificate CORNER NO. DAMS_County SECTION HARRISON TYPE OF MONUMENT: TOWN STATE PLANE COORDINATES: RANGE ELEVATION — M.S.L. DATUM: THETA ANGLE: (101) (127) FIELD BOOK: PAGE . DRAWN BY: BASIS FOR MONUMENT LOCATION Show info such as: History of corner, with reference to Vol. and pg., dates, surveyor; exact description of monument replaced; if location computed, by taped or EDM traverse; landowner remarks, etc. (Use reverse side if necessary) LOCATION (Indicated by 'X') SEAL: HIN SCONS Excavated with backhoe. Found 8x10x39" sandstone down 15". Stone had a drill hole in it and a cross cut as shown. Lowered stone and set ANTHONY B. Harrison monument on top. No resurvey records. **KIEDROWSKI** Dug 6' x 10' x 2' deep hole. REVERSE TIES S-878 Wisconsin Rapids Wig. DATA SHOWN HERE ON CERTIFIED CORRECT: Registered Land Surveyor DATE: 6/27/78 TIE SKETCH SE COR HSE FND. Show at least four ties, also fence lines, roads, topo, size and type of witness trees' and if off road - best way to arrive at corner. 105,80 Ties are to nail and disc. 60NE DEERBORN 2 Eound STORE MAINTENANCE RECORD STREET Date Init. Remarks ôΚ 1/23/80 7-12-85 DK-SS NEW 160NE GONE GONE NE COR 7-27-94 Tel 24-05 Box @ Top

REVISED 1977

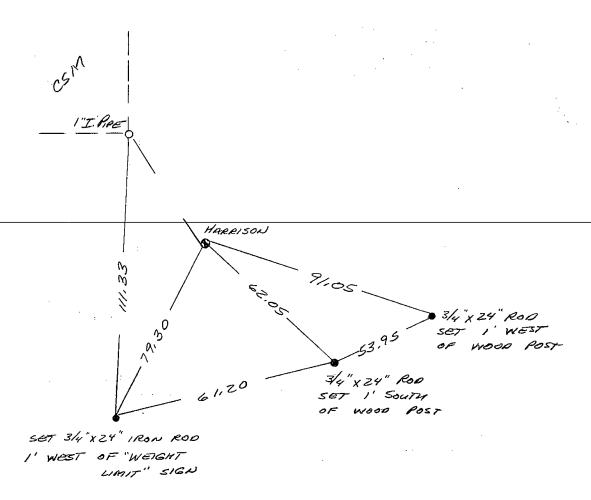

ALL OK, 2-10-00, JG-BZ OK 1-20-10 55