TOWN

06 ADAMS COUNTY COUNTY CORNER NO: 26

ROMPORTOL ID: 41706040020


PUBLIC LAND SURVEY MONUMENT RECORD

HARRISON (BROKEN-TOP) TYPE OF MONUMENT: ADAMS COUNTY COORDINATES, NAD 83 (2007) N. 218849.495 E 538873.684 ELEVATION- - - DATUM 08/06/2018 FIELD WORK DATE:


BASIS FOR MONUMENT LOCATION

1978 - PLS 878 EXCAVATED WITH A BACKHOE AND FOUND THE BOTTOM 12" OF A WOODEN POST, WITH THE HEARTWOOD STILL SOLID. REPLACED THE SAME WITH A HARRISON MONUMENT AND TIED OUT.

2018 - PLS 2994 FOUND A HARRISON MONUMENT WITH A BROKEN-TOP 18" BELOW THE ROAD SURFACE, 1 TIE AND 1 WITNESS. THE MONUMENT AGREES WITH THE EXISTING TIE AND WITNESS. ACCEPTED THE HARRISON MONUMENT WITH A BROKEN-TOP AS THE CORNER LOCATION. SET 3 NEW TIES AND MEASURED TO THE TIES AND WITNESS.

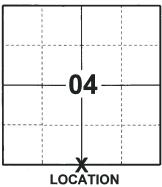

(INDICATE CORNER BY "X")

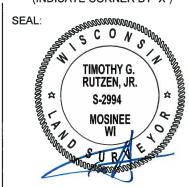

DATA SHOWN HERE ON THIS TIE SHEET IS CORRECT AND COMPLETE TO THE BEST OF MY KNOWLEDGE AND BELIEF.

PROFESSIONAL LAND SURVEYOR


8-30-18 DATE

-TIE SKETCH

NOTE: THE CORNER FALLS 1'± NORTH OF THE CENTERLINE OF DEERBORN AVE.



MIXED WOODS

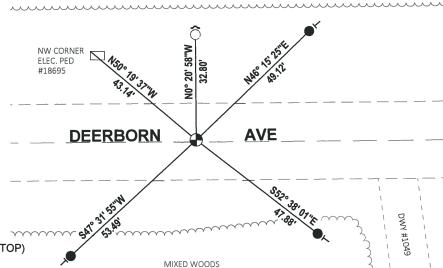

- SET 3/4" x 18" IRON REBAR, 1.50#/FT
- FOUND 3/4" IRON ROD
- FOUND HARRISON MONUMENT (BROKEN-TOP)
- STEEL FENCE POST
- → VINYL "T" POST

Government Land Corner Certificate CORNER NO. DAMS ____County SECTION HARRISON TYPE OF MONUMENT: . **TOWN** STATE PLANE COORDINATES: N. RANGE ELEVATION — M.S.L. DATUM: THETA ANGLE: <u>د ۱۵۱) PAGE 44.1</u> FIELD BOOK: DRAWN BY: _ BASIS FOR MONUMENT LOCATION Show info such as: History of corner, with reference to Vol. and pg., dates, surveyor; exact description of monument replaced; if location computed, by taped or EDM traverse; landowner remarks, etc. (Use reverse side if necessary) LOCATION ANTHO: SEAL: Excavated with backhoe. Found botom 12" of post, heartwood still solid. Replaced it with a Harrison monument. **KIEDROWSKI** No record of any resurveys. S-878 Wisconsin Rapids DATA SHOWN HERE ON CERTIFIED CORRECT: Andhany 83. Registered Land Surveyor DATE: 6/27/78 TIE SKETCH Show at least four ties, also fence lines, roads, topo, size OK BLK. OAK/BT and type of witness trees' and if off road - best way to arrive at corner. 9" BLK. OAK Ties are to nail and disc. NW COR. ELEC. BOX SP 18695 (EASTERLY OF 3 BOXES 2010 DEERBORN MAINTENANCE RECORD Date Init. Remarks N2 1/23/80 22-NN BEFPS COR. , 00° 3/4" RoO BLK. OAK BONE 7-12-85|SS-DK AL1POWER 50, 1-6-90 12-GR u ıı POLE 7-27-94 IG-BS OK ALL JG-B2 JACK -24-05 1-NEW PINE 10 1-21-10

REVISED 1977