17 TOWN

06 RANGE ADAMS COUNTY CORNER NO: 31 ROMPORTOL ID: 41706020000

PUBLIC LAND SURVEY MONUMENT RECORD

HARRISON TYPE OF MONUMENT: ADAMS COUNTY COORDINATES, NAD 83 (2007) N. 218872.152 E. 552116.616 ELEVATION- - - DATUM 08/06/2018 FIELD WORK DATE:


BASIS FOR MONUMENT LOCATION

1974 - PLS 878 THIS CORNER WAS PREVIOUSLY MARKED BY A NUMBER OF OTHER SURVEYS AND FOUND NO LESS THAN SEVEN POSSIBILITIES IN A RADIUS OF ABOUT 50 FEET. THIS CORNER IS A PRIME EXAMPLE OF WHY SURVEYS SHOULD BE MONUMENTED AND RECORDED. RE-RAN THE SECTION AND FOUND THAT THE CORNER MARKED BY PERRY-CARRINGTON WAS MOST NEARLY CORRECT AND MONUMENTED THAT POINT. THIS CORNER WAS PREVIOUSLY MARKED BY A PIDDLEY LITTLE SPIKE. SET A HARRISON MONUMENT AT THE ACCEPTED CORNER LOCATION AND TIED OUT.

2018 - PLS 2994 FOUND A HARRISON MONUMENT 2" BELOW THE ROAD SURFACE. FOUND NO EVIDENCE OF ANY OF THE EXISTING TIES OR WITNESSES. ACCEPTED THE HARRISON MONUMENT AS THE BEST EVIDENCE OF THE CORNER LOCATION. SET 4 NEW TIES AND MEASURED TO THE TIES.



(INDICATE CORNER BY "X")

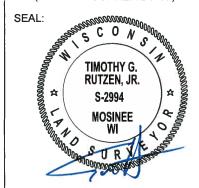

DATA SHOWN HERE ON THIS TIE SHEET IS CORRECT AND COMPLETE TO THE BEST OF MY KNOWLEDGE AND BELIEF.


PROFESSIONAL LAND SURVEYOR

8-30-18 DATE

-TIE SKETCH

NOTE: THE CORNER FALLS 1'± WEST OF THE CENTERLINE OF 8TH AVE AND 21'± NORTH OF THE CENTERLINE OF DEERBORN AVE.



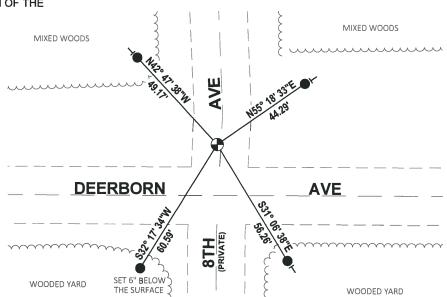

SET 3/4" x 18" IRON REBAR, 1.50#/FT

FOUND HARRISON MONUMENT

VINYL "T" POST

ADAMS COUNTY SECTION Survey Monument Record TOWN TYPE OF MONUMENT: Harrison Standard RANGE STATE PLANE COORDINATES: N__ F... ELEVATION - M.S.L. DATUM: ___ THETA ANGLE: _ FIELD BOOK: _____ _____ PAGE _ BASIS FOR MONUMENT LOCATION (Use reverse side if necessary) LOCATION Show info such as: History of corner, with reference to Vol. and pg, dates, surveyor; exact description of monument replaced; if location computed, by taped or EDM traverse; landowner (Indicated by 'X') SEAL: This corner was previously marked by a number of other surveys and I found no less than seven possibilities in a radius of about 50 feet. This corner is a prime example of why surveys should be monumented and recorded. I re-ran the section and found that the corner marked by Perry-Carrington was most nearly correct and monumented that point. This corner was previously marked by a piddley little spike. COR. O.K. 9-20-75 55 COR. BEEFS 1/23/80 RN-SS CERTIFIED CORRECT: See Reverse Registered Land Surveyor Sine DATE: June 14, 1974 TIE SKETCH Ties are to nail and disc. (Show at least four ties) DEAD 10" Jack Pine /BT (Nail V'above ground) £400 ۵

8" Black Oak /BT

(Nail 2' above ground)

6" Black Oak /BT

(Nail 4' above ground)

DND SIGN CROOKED 6" J. P. Ne DND SIGN Nail 4' Abore GRND DEER BORN AVE. mail 2' Naila'4' Abore Θ Abore ground GRND (NO BLAZE) COR OK 7-12-85 22- X Q 2-6-90 KZ-GR. ALL OK 7-29-94 JG-BS ALL OK 1-6-00-, JG 1-GONE, 1-NEW, 1-24-05-56 2-4-10 55