___01 SECTION 17 TOWN

06 RANGE

ADAMS COUNTY

COUNTY CORNER NO: 33

ROMPORTOL ID: 41706010000

PUBLIC LAND SURVEY MONUMENT RECORD

TYPE OF MONUMENT: HARRISON
ADAMS COUNTY COORDINATES, NAD 83 (2007)

N. 219004.474


E. 557381.415

ELEVATION- — DATUM — — —
FIELD WORK DATE: 11/30/2017


BASIS FOR MONUMENT LOCATION

1974 - PLS 878 CORNER WAS MONUMENTED BY AN UNLICENSED LOCAL RESIDENT WITH A 1" AXLE SHAFT AND A NEW FENCE WAS BUILT FROM THIS POINT GOING NORTH. IN QUESTIONING THE MAN THAT SET THIS POINT HE HAD NO BASIS WHATSOEVER FOR ITS LOCATION. AFTER A TRAVERSE OF THE SECTION TAKING INTO ACCOUNT VARIOUS OTHER SURVEYS IN THE AREA. THE CORNER WAS MONUMENTED WITH A HARRISON MONUMENT THAT MATCHES THE PERRY-CARRINGTON SURVEY IN THE SOUTHWEST QUARTER. THIS POINT ALSO MATCHES OTHER OLD POSSESSION LINES QUITE WELL.

2017 - PLS 2994 FOUND A HARRISON MONUMENT 4" ABOVE THE GROUND SURFACE. FOUND NO EVIDENCE OF ANY WITNESSES OR TIES. ACCEPTED THE HARRISON MONUMENT AS THE BEST EVIDENCE OF THE CORNER LOCATION. SET 4 NEW TIES AND MEASURED TO THE TIES.

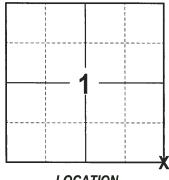

LOCATION (INDICATE CORNER BY "X")

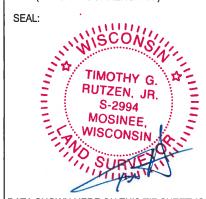

DATA SHOWN HERE ON THIS TIE SHEET IS CORRECT AND COMPLETE TO THE BEST OF MY KNOWLEDGE AND BELIEF.


PROFESSIONAL LAND SURVEYOR

DATE /-4-18

– <u>TIE SKETCH</u>

NOTE: THE CORNER FALLS 56'± SOUTH OF THE CENTERLINE OF THE TRAIL AND 10'± EAST OF THE CENTERLINE OF DWY #697.



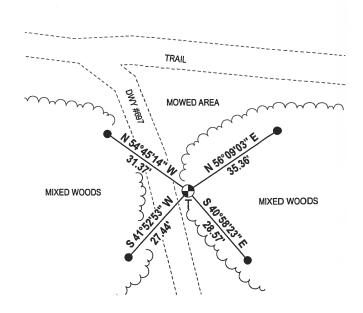

● 3/4" x 18" IRON REBAR SET, 1.50#/FT HARRISON FOUND ¬ VINYL "T" POST

ADAMS COUNTY

Survey Monument Record

TYPE OF MONUMENT: Harrison Standard

STATE PLANE COORDINATES: N______

E
ELEVATION — M.S.L. DATUM: _____

THETA ANGLE: ______
FIELD BOOK: ______ PAGE _____

CORNER NO	
SECTION	
TOWN	17
RANGE	6
LOCATION (Indicated by 'X')	

BASIS FOR MONUMENT LOCATION

(Use reverse side if necessary)

Show info such as: History of corner, with reference to Vol. and pg, dates, surveyor; exact description of monument replaced; if location computed, by taped or EDM traverse; landowner remarks, etc.

This corner was monumented by an unlicensed local resident with a 1" axle shaft and a new fence was built from this point going north. In questioning the man that set this point he had no basis whatsoever for its location. I traversed the section taking into account various other surveys in the area. The corner now monumented with a Harrison monument matches the Perry-Carrington survey in the Southwest Quarter. This point also matches other old possession lines quite well.

COR. O.K. 9-20-75 ES

OK 1/23/80 RN-SS


CERTIFIED CORRECT:

Solveyor

Registered Land Surveyor

DATE: June 14, 1974

See Reverse SIDE

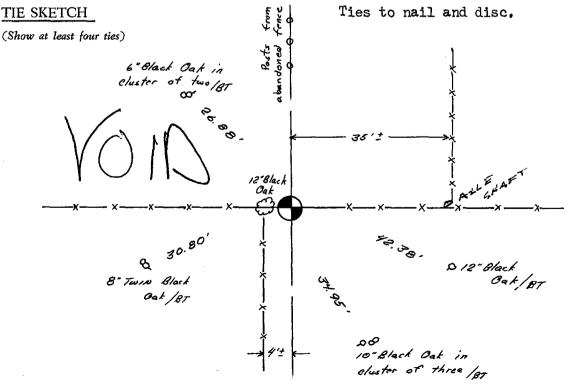

GONE 6" STUMP 12" BLK Oak 00 Nothing Available Down fence AXLE SHOFT BLK OAK OX 1990 Norhing Available ŏ (DEAD) Immediately West OF Drive was 20 "BLK OAK ? NO BLUZE FAD, NAIL STILL GOOD)

COR OK 7-12-85 2 NEW TIES-1-31-90 KZ GR SS-DK ALL OK 7-29-94 JG-BS R-GONE, 2-NEW TIES, 2-10-05, JG-BZ 2-GONE, 1-NEW, 1-24-05-JG DK 2-4-10 SS