

08 SECTION 17 TOWN 06 RANGE

# ADAMS COUNTY

COUNTY CORNER NO: 36

ROMPORTOL ID: 41706082000

## PUBLIC LAND SURVEY MONUMENT RECORD

TYPE OF MONUMENT: HARRISON  
ADAMS COUNTY COORDINATES, NAD 83 (2007)

N. 216210.837

E. 536292.821


ELEVATION-      DATUM     

FIELD WORK DATE: 06/07/2017

### BASIS FOR MONUMENT LOCATION


1978- PLS 878 AFTER DIGGING WITH A BACKHOE FOUND NO EVIDENCE OF ANY PREVIOUS MONUMENTATION. SET HARRISON, EQUIDISTANT ON A LINE BETWEEN ADJACENT SECTION CORNERS.

2017 - PLS 2994 FOUND HARRISON MONUMENT 6" BELOW THE ROAD SURFACE. ALL WITNESSES HAVE BEEN DESTROYED. ACCEPTED HARRISON AS BEST EVIDENCE OF CORNER LOCATION, SET 4 NEW TIES.

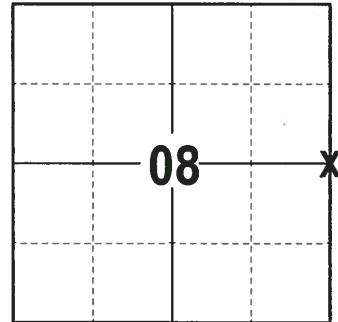

**LOCATION**  
(INDICATE CORNER BY "X")

SEAL:

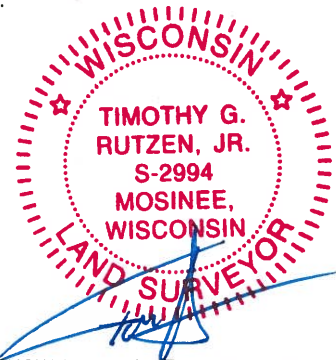


DATA SHOWN HERE ON THIS TIE SHEET IS CORRECT AND COMPLETE TO THE BEST OF MY KNOWLEDGE AND BELIEF.

PROFESSIONAL LAND SURVEYOR

DATE 6/26/17


### - TIE SKETCH -

NOTE: THE CORNER FALLS 2'± WEST OF THE CENTERLINE OF 11TH AVE.

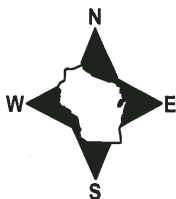

MIXED WOODS

AIRPORT RUNWAY

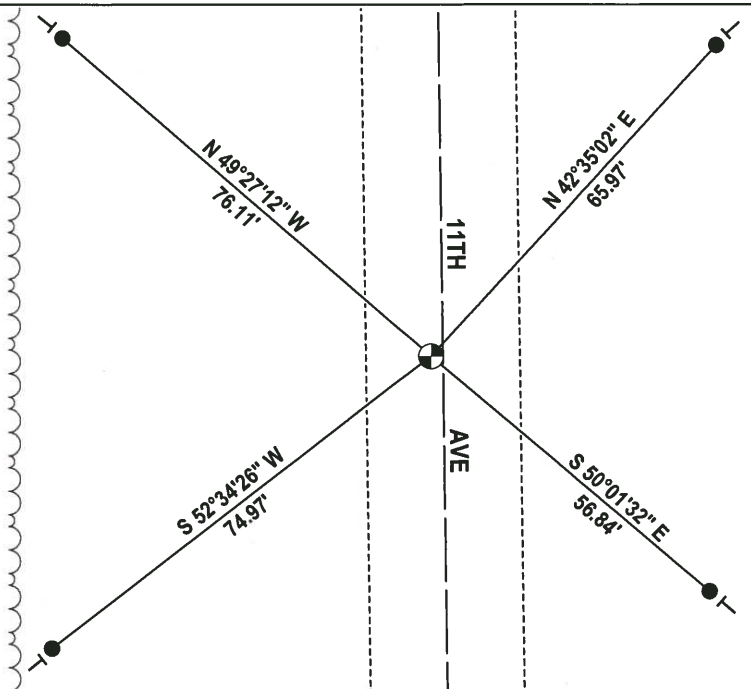


- 3/4" x 18" IRON REBAR SET, 1.50#/FT
- ⊙ HARRISON FOUND
- └ VINYL "T" POST

# Government Land Corner Certificate

ADAMS County  
 TYPE OF MONUMENT: HARRISON  
 STATE PLANE COORDINATES: N \_\_\_\_\_  
 E \_\_\_\_\_  
 ELEVATION — M.S.L. DATUM: \_\_\_\_\_  
 THETA ANGLE: \_\_\_\_\_  
 FIELD BOOK: 54 PAGE 44  
 DRAWN BY: B. MERZ

CORNER NO. 36  
 SECTION 8  
 TOWN 17  
 RANGE 6

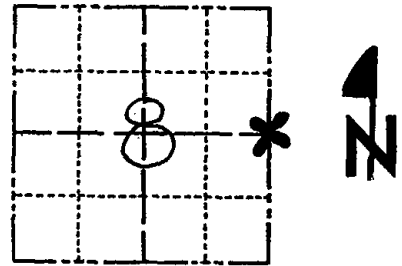

LOCATION (Indicated by 'X')

## BASIS FOR MONUMENT LOCATION

Show info such as: History of corner, with reference to Vol. and pg., dates, surveyor; exact description of monument replaced; if location computed, by taped or EDM traverse; landowner remarks, etc. (Use reverse side if necessary)

Set equidistant and on line between adjacent section corners after digging with a backhoe revealed no evidence of any previous monumentation.

SEAL:




DATA SHOWN HERE ON CERTIFIED CORRECT:

Anthony B. Kiedrowski  
Registered Land Surveyor

DATE: 6/27/78

## TIE SKETCH

Show at least four ties, also fence lines, roads, topo, size and type of witness trees' and if off road - best way to arrive at corner.

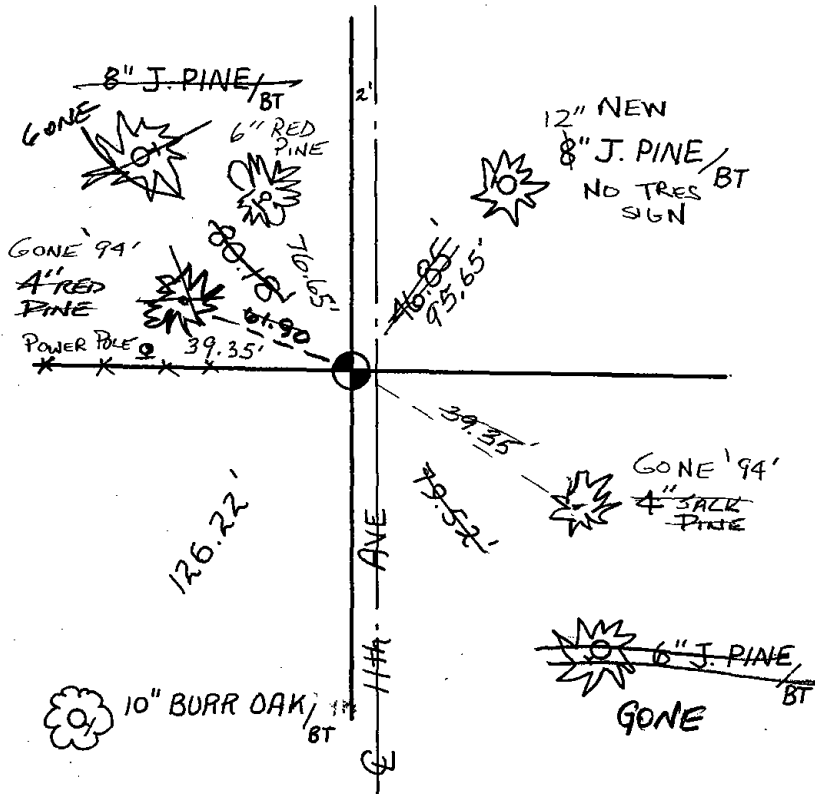

## MAINTENANCE RECORD

Date	Init.	Remarks
3/6/80	RN-SS	MON REEPS TIES OK
7-12-85	SS-DK	ALL OK
2-6-90	KZ-CR	2 GONE 2 NEW
2-10-00	JG-BZ	OK
1-24-05	JG	OK
2-10-10	SS	OK