17 TOWN

06 RANGE ADAMS COUNTY CORNER NO: 37 ROMPORTOL ID: 41706092000


PUBLIC LAND SURVEY MONUMENT RECORD

| TYPE OF MONUMENT: | HARRISON (BROKEN-TOP) |
|-----------------------------|-----------------------|
| ADAMS COUNTY COORDINAT | ES, NAD 83 (2007) |
| N216178.341 | _ |
| E. 541546.380 | <u> </u> |
| ELEVATION | DATUM — — |
| FIELD WORK DATE: 08/07/2018 | |


BASIS FOR MONUMENT LOCATION

1973 - PLS 878 EXCAVATED WITH A BACKHOE AND FOUND NO EVIDENCE OF THE CORNER. CALCULATED THE CORNER POSITION ON LINE EQUIDISTANT BETWEEN SECTION CORNERS. SET A HARRISON MONUMENT AT THE CALCULATED POSITION AND TIED OUT.

2018 - PLS 2994 FOUND A HARRISON MONUMENT WITH A BROKEN-TOP 6" BELOW THE GROUND SURFACE AND 1 TIE. THE MONUMENT AGREES WITH THE EXISTING TIE. ACCEPTED THE HARRISON MONUMENT WITH A BROKEN-TOP AS THE CORNER LOCATION, SET 3 NEW TIES AND MEASURED TO THE TIES.

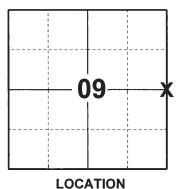

(INDICATE CORNER BY "X")

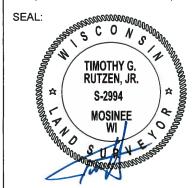

DATA SHOWN HERE ON THIS TIE SHEET IS CORRECT AND COMPLETE TO THE BEST OF MY KNOWLEDGE AND BELIEF.

PROFESSIONAL LAND SURVEYOR


8-30-18 DATE

-TIE SKETCH

NOTE: THE CORNER FALLS 26'± WEST OF THE CENTERLINE OF 10TH AVE.



- SET 3/4" x 18" IRON REBAR, 1.50#/FT
- FOUND 1" O.D. IRON PIPE
- FOUND 1-1/4" O.D. IRON PIPE
- FOUND HARRISON MONUMENT (BROKEN-TOP)
- VINYL "T" POST

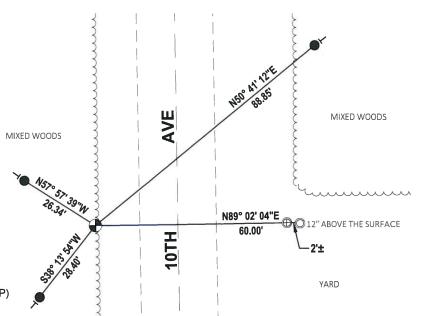

CORNER NO. _33 ADAMS COUNTY SECTION Survey Monument Record TOWN TYPE OF MONUMENT: HARRISON RANGE STATE PLANE COORDINATES: N_ F. ELEVATION - M.S.L. DATUM: _ THETA ANGLE: _ 108 PAGE _ FIELD BOOK: ___ BASIS FOR MONUMENT LOCATION (Use reverse side if necessary) ANTHONY B. KIEDROWSKI S-878 Wisconsin Rapi Wis. Show info such as: History of corner, with reference to Vol. and pg, dates, surveyor; exact description of monument replaced; if location computed, by taped or EDM traverse; landowner remarks, etc. LOCATION SEAL: Excavated with backhoe, found no evidence of corner. Corner set on line equidistant between section corners. 3 ROLEN 9-27-75 55 SEC710N " TIES OK 3/6/80 KN-55 CERTIFIED CORRECT: Futhered Land Surveyor 7-12-85 SS.DK 2-6-90 KZ-GR 1 NEW 2-6-90 2 NEW July DATE: . 7-29-94 JG-BS 1-60NE 1-NEW TIE, 2-10-00, JG-BZ TIE SKETCH (Show at least four ties) 1-21-10 FD TOP 6" BROKEN OFF - SET STEEL POST/SIGN 8"JACK PINE 10" J. Pine No blaze IN yorr IN fence CSM 60' E7457 NO TRES 941 SigN GONE OPPORT GONE POLIE R 52.00 DEAD

JACK BT AT FENCE