

12
SECTION

17
TOWN

06
RANGE

ADAMS COUNTY

COUNTY CORNER NO: 52
ROMPORTOL ID: 41706120020

PUBLIC LAND SURVEY MONUMENT RECORD

TYPE OF MONUMENT: HARRISON
ADAMS COUNTY COORDINATES, NAD 83 (2007)

N. 213635.176

E. 554777.332


ELEVATION- DATUM

FIELD WORK DATE: 08/06/2018

BASIS FOR MONUMENT LOCATION

1971 - PLS 981 FOUND A "RR" SPIKE AT THE CORNER LOCATION. SET A HARRISON MONUMENT AT THE "RR" SPIKE LOCATION AND TIED OUT.


2018 - PLS 2994 FOUND A HARRISON MONUMENT 6" BELOW THE ROAD SURFACE AND 1 TIE. THE MONUMENT AGREES WITH THE EXISTING TIE. ACCEPTED THE HARRISON MONUMENT AS THE CORNER LOCATION. SET 3 NEW TIES AND MEASURED TO THE TIES.

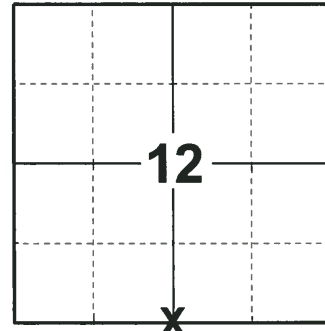

LOCATION

(INDICATE CORNER BY "X")

SEAL:

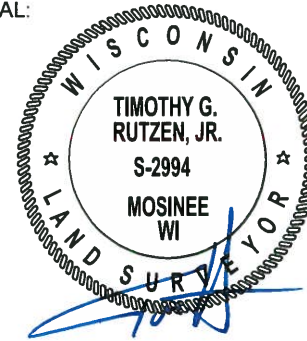



DATA SHOWN HERE ON THIS TIE SHEET IS CORRECT AND COMPLETE TO THE BEST OF MY KNOWLEDGE AND BELIEF.

PROFESSIONAL LAND SURVEYOR

DATE 8-30-18

TIE SKETCH

NOTE: THE CORNER FALLS 1± SOUTH OF THE CENTERLINE OF CTH M AND 0.5± EAST OF THE CENTERLINE OF 7TH AVE.

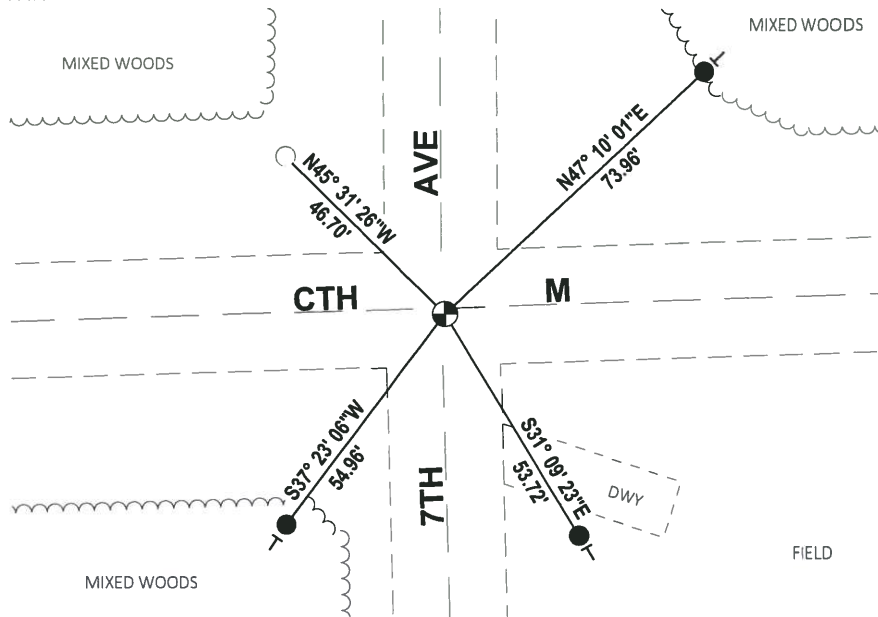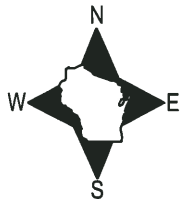

- SET 3/4" x 18" IRON REBAR, 1.50#/FT
- FOUND 3/4" IRON ROD
- ⊙ FOUND HARRISON MONUMENT
- VINYL "T" POST

ADAMS COUNTY

Survey Monument Record

TYPE OF MONUMENT: 30" HARRISON

STATE PLANE COORDINATES: N. _____

E. _____

ELEVATION — M.S.L. DATUM: _____

THETA ANGLE: _____


FIELD BOOK: 104 PAGE 73

CORNER NO. 41

SECTION 13

TOWN 17

RANGE 6

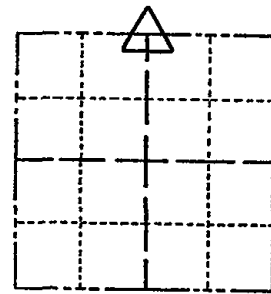

LOCATION
(Indicated by 'X')

SEAL:

BASIS FOR MONUMENT LOCATION

(Use reverse side if necessary)

Show info such as: History of corner, with reference to Vol. and pg, dates, surveyor; exact description of monument replaced; if location computed, by taped or EDM traverse; landowner remarks, etc.

Found "RR" spike and set monument

August 23, 1971

Sam T. Mullen R.L.S. S-981

COR O.K. 9-27-75 SS
 COR. BEEPS 3/12/80 RN-SS
 ALL OK 7-16-85 DK
 2-GONE - 3 NEW 1990 KZ
 1-GONE, 1-NEW 7-29-94 JG-135
 1-GONE, 2-10-00, JG-BZ / OR 3-1-05 DA-SS
 " 7-4-10 -SS

CERTIFIED CORRECT:

Registered Land Surveyor

DATE: _____

TIE SKETCH

(Show at least four ties)

