FIELD WORK DATE:

6 ADAMS COUNTY

COUNTY CORNER NO: 80

ROMPORTOL ID: 41706242000

PUBLIC LAND SURVEY MONUMENT RECORD


HARRISON (BROKEN-TOP) TYPE OF MONUMENT: ADAMS COUNTY COORDINATES, NAD 83 (2007) N. **205733.575** E. 557469.337 ELEVATION-DATUM - -

11/30/2017


BASIS FOR MONUMENT LOCATION

1979 - PLS 1167 SET THE CORNER EQUIDISTANT AND ON LINE BETWEEN ADJACENT SECTION CORNERS. THIS CORNER WAS ESTABLISHED BY TRAVERSING THE EAST LINE OF 24-17-6E. SEARCHED BOTH THE VICINITY OF THE FENCE CORNER AND IN THE LOCATION AS SET AND FOUND NO CORNER EVIDENCE. SET A HARRISON MONUMENT AT THE CALCULATED LOCATION AND TIED OUT.

2017 - PLS 2994 FOUND A HARRISON MONUMENT WITH A BROKEN-TOP 10" BELOW A TIPPED OVER OAK TREE AND 2 WITNESS TREES. THE MONUMENT AGREES WITH THE EXISTING WITNESS TREES. ACCEPTED THE HARRISON MONUMENT WITH A BROKEN-TOP AS THE CORNER LOCATION. SET 4 NEW TIES AND MEASURED TO THE TIES AND WITNESS TREES.

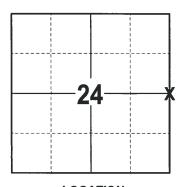

LOCATION (INDICATE CORNER BY "X")

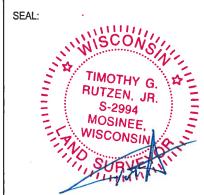

DATA SHOWN HERE ON THIS TIE SHEET IS CORRECT AND COMPLETE TO THE BEST OF MY KNOWLEDGE AND BELIEF.

PROFESSIONAL LAND SURVEYOR


- TIE SKETCH

NOTE: THE CORNER FALLS 38'± SOUTH OF THE FENCE CORNER.



 3/4" x 18" IRON REBAR SET, 1.50#/FT THARRISON (BROKEN-TOP) FOUND VINYL "T" POST

WITNESS TREE FOUND

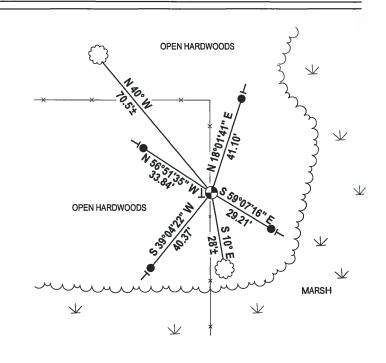

Government Land Co	orner Certificate			<i>(</i> ()
V 1-	Combi		CORNER NO	80.
TYPE OF MONUMENT:	County		SECTION .	24
STATE PLANE COORDINATES:			TOWN .	
	<u> </u>		RANGE .	6E
ELEVATION — M.S.L. DATUM	I:		<u> </u>	_
THETA ANGLE:	PAGE			
DRAWN BY: BASLER	PAGE			. .
				→ N
BASIS FOR MONUMENT L	OCATION		ļļ	
Show info such as: History of corner	, with reference to Vol.			
and pg., dates, surveyor; exact description of monument replaced; if location computed, by taped or EDM traverse; landowner remarks, etc. (Use reverse side if necessary)			LOCATION	_
		SEAL:	(Indicated by X')	
Set Corner equidista		between	A SECTION AND AND AND ADDRESS OF THE PERSON ADDRESS OF THE PERSON AND ADDRESS OF THE PERSON AND ADDRESS OF THE PERSON AND ADDRESS OF THE PERSON ADDR	CREETERS.
adjacent Section Cor This Corner establish		ng the East	Alexander Control of the Control of	
Line 24-17-6E.	•	-		
We searched both the and in Corner as se			WAYNER	ASI FD
evidence.	o, buo round no	marker	WAYNE E 116 WIS. RAI WIS.	BASLER TA
v	- M B		WIS. RAI	PIDS, 🦸 🧗
OK. 9-25-85 55		ĺ	WIS. WIS.	
OK 413195 CR.	-		SUR	VE SEEDER
3- NEW MON. OK		DATA	SHOWN HERE ON	14 150
Z. GONE, Z-NEW,	3-2-05 TC	CERTI	DED CORRECT:	1
02-10-10 - OAK TREE		DISTURBED A	arm Bo	sh
TIES COME IN TO	ROOT BALL - TIES	REMAIN Register	ed Land Surveyor	-
·		DATE:		19
THE OVEROU	£n.	ter farm Drive A	+ 1st House	
TIE SKETCH	•	it of 7th Ave. c ough fields	on Duck Cree 1	۲,
Show at least four ties, also fence li and type of witness trees' and if off	road - best way to	1	-Black	\mathcal{T}
	BLK ONK DOP DE	10	Spx. 15 OAK	Blazed
BT/DNO NEW	21CN 05:	,	way	
Spr Godry	37 **	+	* = 3	12 WHITE DAK 6 S. OF FENCE
Blazed 4	o o	x 60 18:	02	DND SIGN '0
Black BURR/BT	19.83		1914	\ \
DND SIGN	<i>DJ</i>		,- <u> </u>	
	Harr In Ro	ots at	\	, I
	Base	of Tree?	\sim	j
	48.0	1 3 a. W	SPK. ZOOAK/E	Vazed
ó	<i>2</i> 5	* 6 (B)	Spk. 20046/2	18/
C	o) N€W	1 Land 11K	J. A.	/
	SPK. BOAK	4 John		
	Blazed Burn W.OAK	8" SIGN US		
	GONE	* hun o	,	

MAINTENANCE RECORD

DATE	BY WHOM	REMARKS
		
<u> </u>		
<u> </u>		
	·	
<u> </u>		
-		