

PUBLIC LAND SURVEY MONUMENT RECORD

TYPE OF MONUMENT: 1-1/4" O.D. IRON PIPE WITH ALUMINUM CAP
 ADAMS COUNTY COORDINATES, NAD 83 (2007)

N. 221589.866

E. 567700.700


ELEVATION- _____ DATUM _____

FIELD WORK DATE: 03/27/2019

BASIS FOR MONUMENT LOCATION

1980 - PLS 878 NO RECORD OF ANY SURVEYS. NO STRONG POSSESSION LINES IN AREA. A VERY WET SWAMP DID NOT FIND ANY OF ORIGINAL CORNERS OF WITNESS. SO SET CORNER ON A STRAIGHT LINE BETWEEN SECTION CORNERS AND IN PROPORTION TO ORIGINAL NOTE DISTANCE.

2019 - PLS 2675 FOUND 1 1/4" O.D. IRON PIPE WITH ALUMINUM CAP 18" ABOVE THE GROUND AND DID NOT RECOVER ANY TIES OR WITNESSES. ACCEPTED THE 1 1/4" O.D. IRON PIPE WITH ALUMINUM CAP AS THE CORNER LOCATION AND SET 4 NEW TIES.

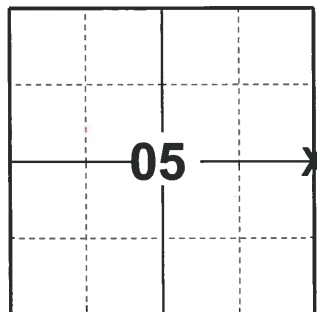

LOCATION
 (INDICATE CORNER BY "X")

SEAL:





DATA SHOWN HERE ON THIS TIE SHEET IS CORRECT AND COMPLETE TO THE BEST OF MY KNOWLEDGE AND BELIEF.

PROFESSIONAL LAND SURVEYOR

DATE 5/1/19

- TIE SKETCH

NOTE: CHECK WITH OWNER OF THE NE/SE OF SECTION 5 FOR EASY ACCESS.

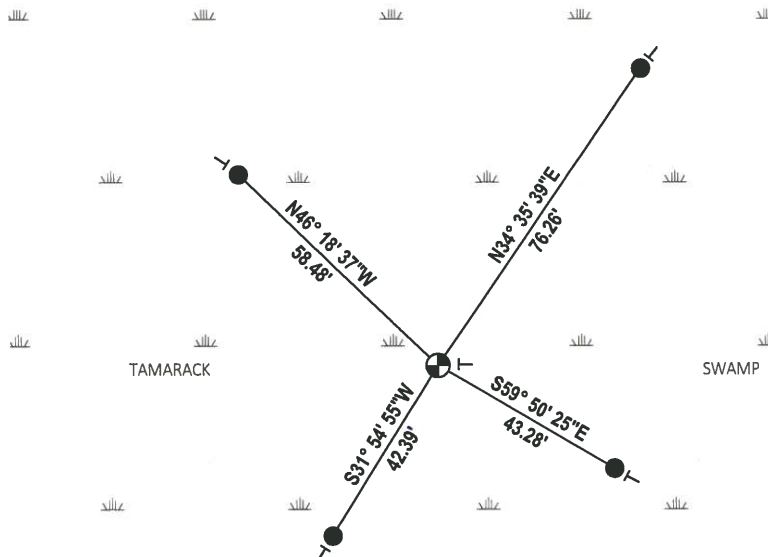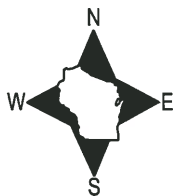


- SET 3/4" x 48" IRON REBAR, 1.50#/FT
- ⊕ FOUND 1 1/4" O.D. IRON PIPE W/ALUM. CAP
- ┌ VINYL "T" POST

Government Land Corner Certificate

Adams County
 TYPE OF MONUMENT: 1/4" x 6' IRON PIPE/ALUM. CAP
 STATE PLANE COORDINATES: N 43°58'26.7"
HAND HELD NAY W 89°40'41.8"
 ELEVATION — M.S.L. DATUM: _____
 THETA ANGLE: _____
 FIELD BOOK: 83 PAGE 129
 DRAWN BY: R. NUBER

CORNER NO. 16
 SECTION 4
 TOWN 17
 RANGE 7

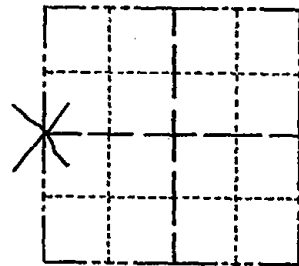

LOCATION
(Indicated by 'X')

BASIS FOR MONUMENT LOCATION

Show info such as: History of corner, with reference to Vol. and pg., dates, surveyor; exact description of monument replaced; if location computed, by taped or EDM traverse; landowner remarks, etc. (Use reverse side if necessary)

No record of any surveys. No strong possession lines in area. A very wet swamp. Did not find any of original corner of witness. So set corner on a straight line between section corners and in proportion to original note distance.

SEAL:



DATA SHOWN HERE ON
CERTIFIED CORRECT:

Anthony B. Kiedrowski
Registered Land Surveyor

DATE: 8/1/80

TIE SKETCH

* CHECK WITH OWNER OF THE NE/SE 1/4 SEC 5 FOR EASY ACCESS

Show at least four ties, also fence lines, roads, topo, size and type of witness trees and if off road - best way to arrive at corner.

