

11
SECTION

17
TOWN

07
RANGE

ADAMS COUNTY

COUNTY CORNER NO.: 39

ROMPORTOL ID: 41707112000

PUBLIC LAND SURVEY MONUMENT RECORD

TYPE OF MONUMENT: HARRISON
ADAMS COUNTY COORDINATES, NAD 83 (2007)

N. 216339.982

E. 583633.059


ELEVATION- DATUM

FIELD WORK DATE: 03/21/2019

BASIS FOR MONUMENT LOCATION

1981 - PLS 878 NO RECORD OF RESURVEY. NO EVIDENCE OF CORNER FOUND. CORNER IS SET ON LINE AND EQUIDISTANT BETWEEN SECTION CORNERS.


2019 - PLS 2675 FOUND HARRISON FLUSH WITH THE GROUND AND 2 WITNESSES. THE MONUMENT APPEARS TO BE LEANING BUT AGREES WITH BOTH FOUND WITNESSES AND IT WAS VERIFIED TO BE ON A NEAR STRAIGHT LINE AND EQUIDISTANT BETWEEN THE NORTHEAST AND SOUTHEAST CORNER OF SECTION 11. ACCEPTED THE HARRISON AS THE CORNER LOCATION. SET 4 NEW TIES AND MEASURED TO THE WITNESSES.

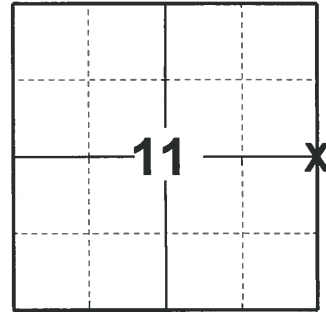

LOCATION

(INDICATE CORNER BY "X")

SEAL:


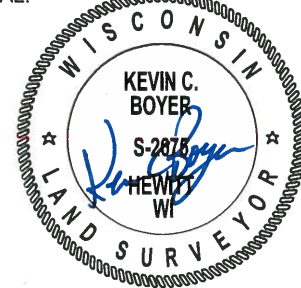


DATA SHOWN HERE ON THIS TIE SHEET IS CORRECT AND COMPLETE TO THE BEST OF MY KNOWLEDGE AND BELIEF.

PROFESSIONAL LAND SURVEYOR

DATE 5/1/19

- TIE SKETCH

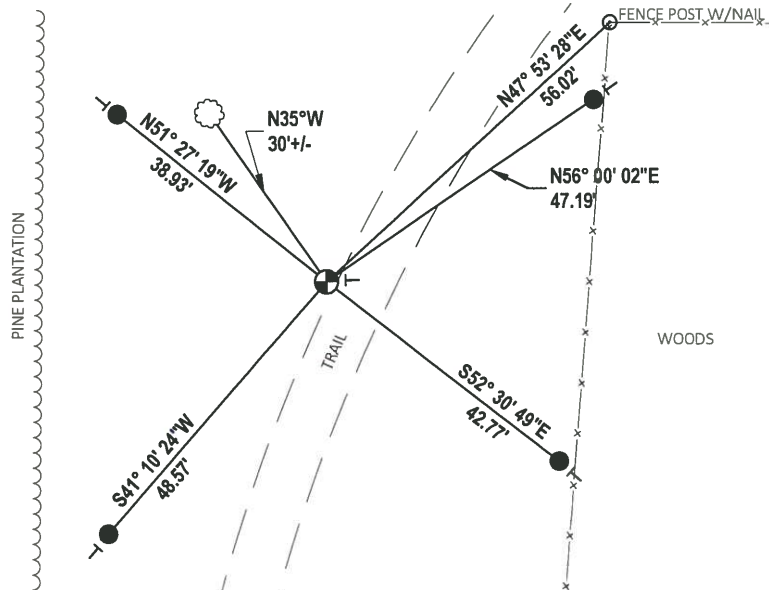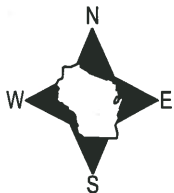


- SET 3/4" x 18" IRON REBAR, 1.50#/FT
- ⊕ FOUND HARRISON MONUMENT
- ⊕ VINYL "T" POST
- ☁ WITNESS TREE

Government Land Corner Certificate

ADAMS County
 TYPE OF MONUMENT: HARRISON
 STATE PLANE COORDINATES: N 43° 57' 34.2"
 HAND HELD NAVIGATION W 89° 37' 04.1"
 ELEVATION — M.S.L. DATUM: _____
 THETA ANGLE: _____
 FIELD BOOK: 87 PAGE 126A
 DRAWN BY: R. NUBER

CORNER NO. 39
 SECTION 11
 TOWN 17
 RANGE 7

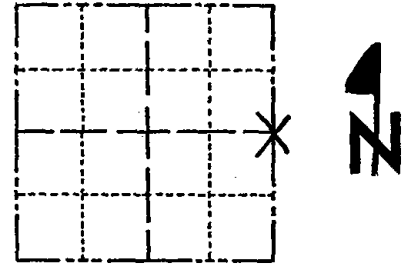

LOCATION
(Indicated by 'X')

SEAL:



DATA SHOWN HERE ON
CERTIFIED CORRECT:

Anthony B. Kiedrowski
Registered Land Surveyor

DATE: 2/3/81

BASIS FOR MONUMENT LOCATION

Show info such as: History of corner, with reference to Vol. and pg., dates, surveyor; exact description of monument replaced; if location computed, by taped or EDM traverse; landowner remarks, etc. (Use reverse side if necessary)

No record of resurvey. No evidence of corner found. Corner is set on line and equidistant between Section corners.

3-18-87 FENCE LINE OF 1900'S
TO 1900'S HARRISON

TIE SKETCH

Show at least four ties, also fence lines, roads, topo, size and type of witness trees and if off road - best way to arrive at corner.

