25 SECTION

## **DATE ADAMS COUNTY**

COUNTY CORNER NO: 100

ROMPORTOL ID: 41804252000


## PUBLIC LAND SURVEY MONUMENT RECORD

TYPE OF MONUMENT:	HARRISON
ADAMS COUNTY COORDINATES, NAD 83 (2007)	
N <b>232105.792</b>	
E. 494662.780	
L. 494002.700	
ELEVATION DATUM_	
FIELD WORK DATE: 12/18/2017	


## BASIS FOR MONUMENT LOCATION

2013 - PLS 1478 RE-DRAFTED PRIOR TIE SHEET BY SAM T. MULLEN R.L.S. S-981 FROM 1971. MULLEN FOUND A NAIL AT THE CORNER LOCATION, SET A HARRISON MONUMENT AND TIED

2017 - PLS 2994 FOUND A HARRISON MONUMENT 8" BELOW THE ROAD SURFACE, 1 PROPERTY IRON, 1 TIE AND 3 WITNESSES. THE MONUMENT AGREES WITH THE EXISTING TIE AND WITNESSES. ACCEPTED THE HARRISON MONUMENT AS THE CORNER LOCATION. SET 2 NEW TIES AND MEASURED TO THE TIES AND WITNESSES.

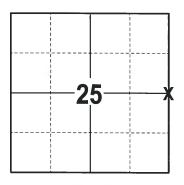


**LOCATION** (INDICATE CORNER BY "X")

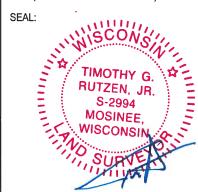

DATA SHOWN HERE ON THIS TIE SHEET IS CORRECT AND COMPLETE TO THE BEST OF MY KNOWLEDGE AND BELIEF.

PROFESSIONAL LAND SURVEYOR

1-4-18

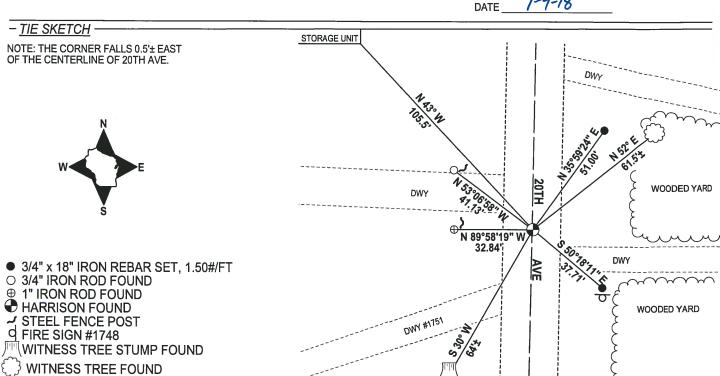

## U.S PUBLIC LAND SURVEY MONUMENT RECORD CORNER NO. 100 SECTION 25 ADAMS COUNTY, WISCONSIN TOWN 18N RANGE 4E TYPE OF MONUMENT: HARRISON MONUMENT STATE PLANE COORDINATES: N: NOT APPLICABLE E: NOT APPLICABLE ELEVATION \_ MSL DATUM: NOT APPLICABLE THETA ANGLE: NOT APPLICABLE FIELD BOOK: 104 PAGE: 59 DRAWN BY: ERIC SCHOOT LOCATION BASIS FOR MONUMENT LOCATION Show info such as: History of corner, with reference to Vol. and pg., dates, surveyor; exact description of monument replaced if location computed, by taped or EDM traverse, landowner remarks, etc. Found Nail and set monument. July 21, 1971 Sam T. Mullen R.L.S. S-981 REGISTERED)LAND SURVEYOR THIS IS A COMPILATION AND REDRAFT OF PREVIOUS MONUMENT RECORDS. DATE: 30 December, 2013 BASIS FOR MONUMENT LOCATION IS FROM ORIGINAL REMONUMENTATION. S.E. Corner TIE SKETCH: No Scale Storage Bld. 18" Black Oak (Conc.) New New 2013 Woods Trail Solid Iron

R.R. Spike Oak

MAINTENANCE RECORD DATE INIT. | REMARKS