

PUBLIC LAND SURVEY MONUMENT RECORD

TYPE OF MONUMENT: HARRISON (BROKEN-TOP)
 ADAMS COUNTY COORDINATES, NAD 83 (2007)

N. 250506.036

E. 501822.321


ELEVATION- _____ DATUM _____

FIELD WORK DATE: 10/15/2018

BASIS FOR MONUMENT LOCATION

1980 - PLS 878 EXCAVATED WITH A BACKHOE AND FOUND THE BOTTOM 12" OF 3" DIA. ROTTED WOOD STAKE WITH A VERY SQUARE 8" COLUMN OF DISTURBED SOIL RIGHT A LONG SIDE. SET A HARRISON MONUMENT AND TIED OUT.


2018 - PLS 2675 FOUND A MAG NAIL IN THE ROAD SURFACE, 1 TIE AND 1 WITNESS TREE. REMOVED THE MAG NAIL AND FOUND A HARRISON MONUMENT WITH A BROKEN-TOP 24" BELOW THE ROAD SURFACE. THE MONUMENT AGREES WITH THE EXISTING WITNESS. ACCEPTED THE HARRISON MONUMENT WITH A BROKEN-TOP AS THE CORNER LOCATION. SET 3 NEW TIES AND MEASURED TO THE TIES AND WITNESS TREE.

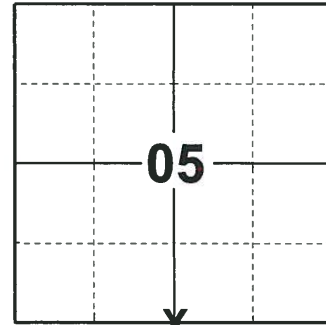

LOCATION

(INDICATE CORNER BY "X")

SEAL:

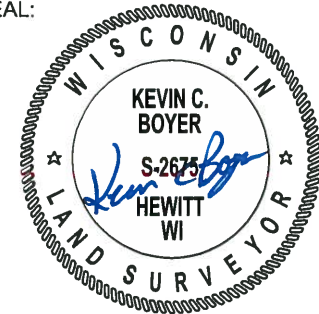



DATA SHOWN HERE ON THIS TIE SHEET IS CORRECT AND COMPLETE TO THE BEST OF MY KNOWLEDGE AND BELIEF.

PROFESSIONAL LAND SURVEYOR

DATE 12/4/2018

- TIE SKETCH

NOTE: THE CORNER FALLS 4± NORTH OF THE CENTERLINE OF COTTONVILLE AVE.

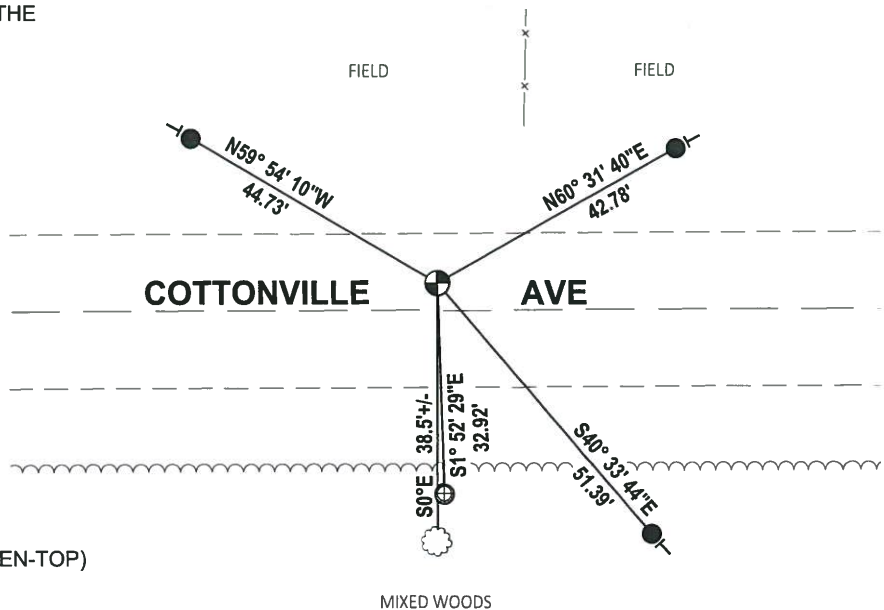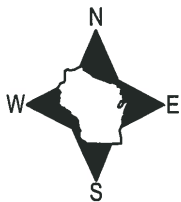


- SET 3/4" x 18" IRON REBAR, 1.50#/FT
- ⊕ FOUND 1" O.D. IRON PIPE
- ⊕ FOUND HARRISON MONUMENT (BROKEN-TOP)
- VINYL "T" POST
- ☁ WITNESS TREE

Government Land Corner Certificate

ADAMS County
 TYPE OF MONUMENT: Harrison
 STATE PLANE COORDINATES: N _____
 E _____
 ELEVATION — M.S.L. DATUM: _____
 THETA ANGLE: _____
 FIELD BOOK: 57 (102) PAGE 120 (80)
 DRAWN BY: S. KMIŁEC

CORNER NO. 24
 SECTION 8
 TOWN 18
 RANGE 5

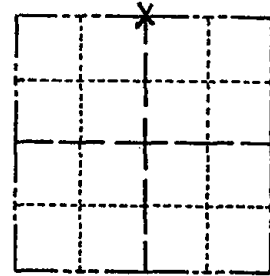

LOCATION
(Indicated by 'X')

BASIS FOR MONUMENT LOCATION

Show info such as: History of corner, with reference to Vol. and pg., dates, surveyor; exact description of monument replaced; if location computed, by taped or EDM traverse; landowner remarks, etc. (Use reverse side if necessary)

Excavated with backhoe. Found bottom 12" of 3" dia rotted wood stake with a very square 8" column of disturbed soil right a long side. Monumented the stake.

SEAL:




DATA SHOWN HERE ON CERTIFIED CORRECT:

Anthony B. Kiedrowski
 Registered Land Surveyor

DATE: 6/5/80

TIE SKETCH

Show at least four ties, also fence lines, roads, topo, size and type of witness trees and if off road - best way to arrive at corner.

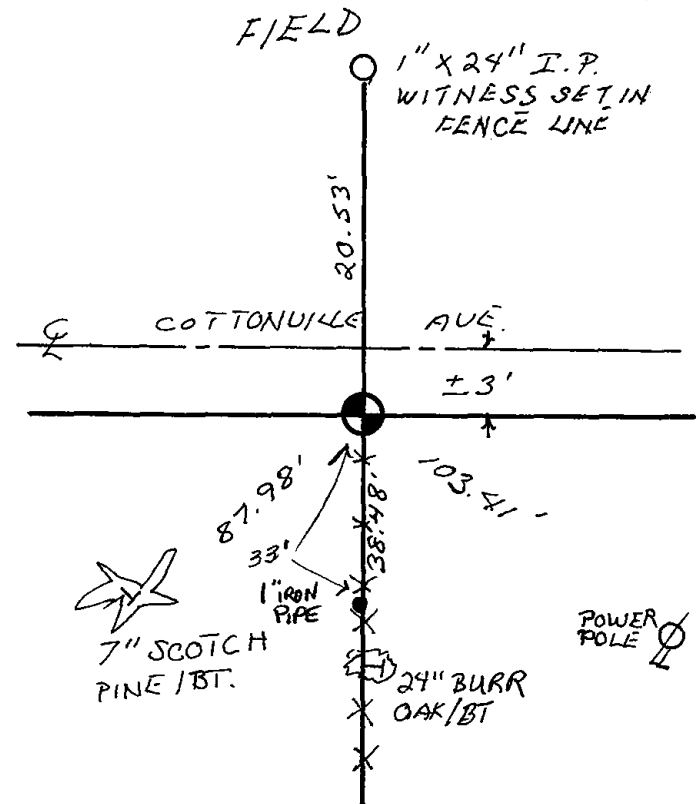

MAINTENANCE RECORD

Date	Init.	Remarks
2-28-83	GR-SS	OK
9-8-92	JG	OK
2-9-98	JG	OK
2-5-03	JG	1-NEW
12-18-07	JG	OK