

PUBLIC LAND SURVEY MONUMENT RECORD

TYPE OF MONUMENT: HARRISON
 ADAMS COUNTY COORDINATES, NAD 83 (2007)

N. 250495.520

E. 507086.404


ELEVATION- _____ DATUM _____

FIELD WORK DATE: 10/15/2018

BASIS FOR MONUMENT LOCATION

1974 - PLS 878 EXCAVATED THE AREA WITH A BACKHOE AND FOUND DEFINITE REMAINS OF WOOD STAKE. REPLACED WITH A HARRISON MONUMENT AND TIED OUT.


2018 - PLS 2675 FOUND A HARRISON MONUMENT 4" BELOW THE ROAD SURFACE, 2 TIES AND 1 PROPERTY IRON. THE MONUMENT AGREES WITH THE EXISTING TIES. ACCEPTED THE HARRISON MONUMENT AS THE CORNER LOCATION. SET 2 NEW TIES AND MEASURED TO THE TIES AND PROPERTY IRON.

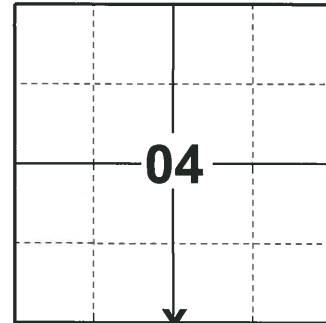

LOCATION

(INDICATE CORNER BY "X")

SEAL:

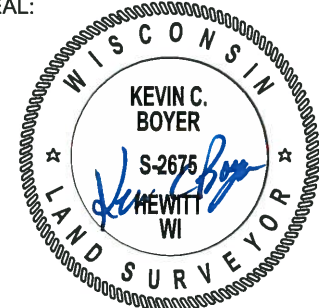



DATA SHOWN HERE ON THIS TIE SHEET IS CORRECT AND COMPLETE TO THE BEST OF MY KNOWLEDGE AND BELIEF.

PROFESSIONAL LAND SURVEYOR

DATE 12/4/2018

TIE SKETCH

NOTE: THE CORNER FALLS 1 1/2" NORTH OF THE CENTERLINE OF COTTONVILLE AVE.

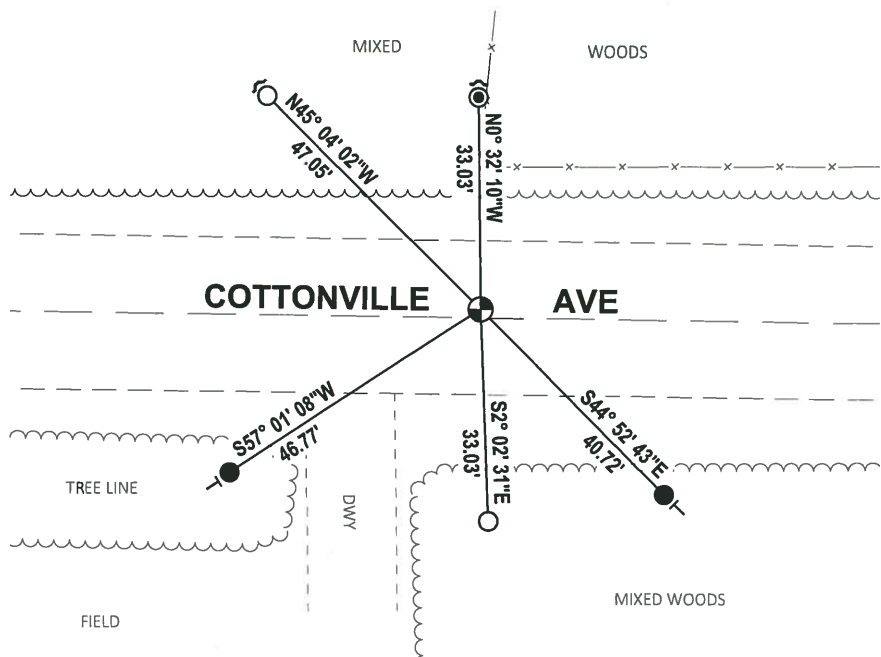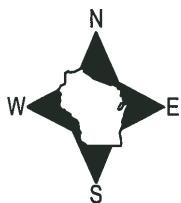

- SET 3/4" x 18" IRON REBAR, 1.50#/FT
- FOUND 3/4" IRON ROD
- ⊙ FOUND 1-1/4" IRON ROD
- ⊕ FOUND HARRISON MONUMENT
- ↘ STEEL FENCE POST
- | VINYL "T" POST

ADAMS COUNTY

Survey Monument Record

TYPE OF MONUMENT: Harrison Standard

STATE PLANE COORDINATES: N _____

E _____

ELEVATION — M.S.L. DATUM: _____

THETA ANGLE: _____


FIELD BOOK: _____ PAGE _____

CORNER NO. 425

SECTION 9

TOWN 18

RANGE 6

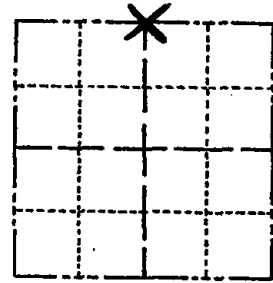

LOCATION
(Indicated by 'X')

SEAL:



BASIS FOR MONUMENT LOCATION

(Use reverse side if necessary)

Show info such as: History of corner, with reference to Vol. and pg, dates, surveyor; exact description of monument replaced; if location computed, by taped or EDM traverse; landowner remarks, etc.

Excavated area with backhoe. Found definite remains of wood stake. Replaced with Harrison monument.

OK 7-28-78 RK-SS
 2-28-83 GR-SS ADD 2 TIES
 1-NEW TIE, MON OK 9-8-92-JG
 OK, 2-9-98-JG
 1-GONE, 2-5-03-JG
 1-GONE, 1-NEW, MON OK, 12-19-07 - JG

CERTIFIED CORRECT:

Anthony B. Kiedrowski
 Registered Land Surveyor

DATE: July 30, 1974

TIE SKETCH

(Show at least four ties)

All ties to nail and disc.

