

PUBLIC LAND SURVEY MONUMENT RECORD

TYPE OF MONUMENT: HARRISON
 ADAMS COUNTY COORDINATES, NAD 83 (2007)

N. 242672.872

E. 494666.130


ELEVATION- DATUM

FIELD WORK DATE: 12/14/2017

BASIS FOR MONUMENT LOCATION

2013 - PLS 1478 RE-DRAFTED PRIOR TIE SHEET BY ANTHONY B. KIEDROWSKI FROM 1974. KIEDROWSKI EXCAVATED WITH A BACKHOE AND FOUND THE DEFINITE REMAINS OF THE BOTTOM 12" OF A DRIVEN HARDWOOD STAKE. REPLACED THE STAKE WITH A HARRISON MONUMENT AND TIED OUT.

2017 - PLS 2994 FOUND A HARRISON MONUMENT FLUSH WITH THE ROAD SURFACE, 2 TIES AND 2 WITNESS TREES. THE MONUMENT AGREES WITH THE EXISTING TIES AND WITNESS TREES. ACCEPTED THE HARRISON MONUMENT AS THE CORNER LOCATION. SET 2 NEW TIES AND MEASURED TO THE TIES AND WITNESS TREES.

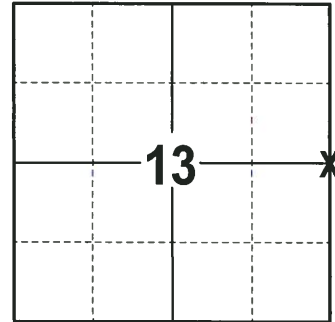

LOCATION
 (INDICATE CORNER BY "X")

SEAL:




DATA SHOWN HERE ON THIS TIE SHEET IS CORRECT AND COMPLETE TO THE BEST OF MY KNOWLEDGE AND BELIEF.

PROFESSIONAL LAND SURVEYOR

DATE 1-4-18

- TIE SKETCH -

NOTE: THE CORNER FALLS 1½ EAST OF THE CENTERLINE OF 20TH AVE.

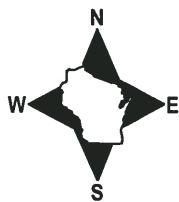

- 3/4" x 18" IRON REBAR SET, 1.50#/FT
- 3/4" IRON ROD FOUND
- ⊕ 2-3/8" O.D. IRON PIPE FOUND
- ⊙ HARRISON FOUND
- ⊠ TELEPHONE PED
- ⊔ FIRE NO. SIGN
- ~ STEEL FENCE POST
- └ VINYL "T" POST
- ☁ WITNESS TREE FOUND

