

17 SECTION 18 TOWN 05 RANGE

ADAMS COUNTY

COUNTY CORNER NO: 64
ROMPORTOL ID: 41805170020

PUBLIC LAND SURVEY MONUMENT RECORD

TYPE OF MONUMENT: HARRISON
ADAMS COUNTY COORDINATES, NAD 83 (2007)

N. 239946.779

E. 501972.191


ELEVATION- - - - DATUM - - - -

FIELD WORK DATE: 10/25/2018

BASIS FOR MONUMENT LOCATION

1979 - PLS 1478 A. B. KIEDROWSKI DUG WITH A BACKHOE AND FOUND THE BOTTOM 15" OF A 4" DIAMETER WOOD POST (ROTTED). THE POST WAS ACCEPTED AS THE CORNER LOCATION. SET A HARRISON MONUMENT AT THE CORNER LOCATION AND TIED OUT.


2018 - PLS 2675 FOUND A HARRISON MONUMENT 6" BELOW THE ROAD SURFACE, 1 TIE, 1 PROPERTY AND 1 WITNESS. THE MONUMENT AGREES WITH THE EXISTING TIE AND WITNESS. ACCEPTED THE HARRISON MONUMENT AS THE CORNER LOCATION. SET 2 NEW TIES AND MEASURED TO THE TIES, PROPERTY IRON AND WITNESS.

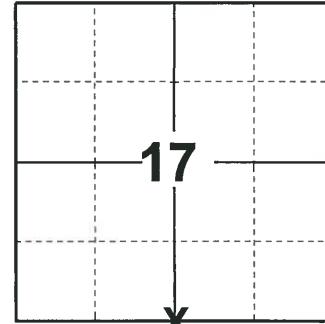

LOCATION

(INDICATE CORNER BY "X")

SEAL:

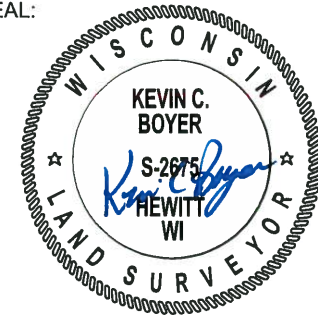



DATA SHOWN HERE ON THIS TIE SHEET IS CORRECT AND COMPLETE TO THE BEST OF MY KNOWLEDGE AND BELIEF.

PROFESSIONAL LAND SURVEYOR

DATE 12/4/2018

- TIE SKETCH

NOTE: THE CORNER FALLS 0.5'± SOUTH OF THE CENTERLINE OF CUMBERLAND AVE.

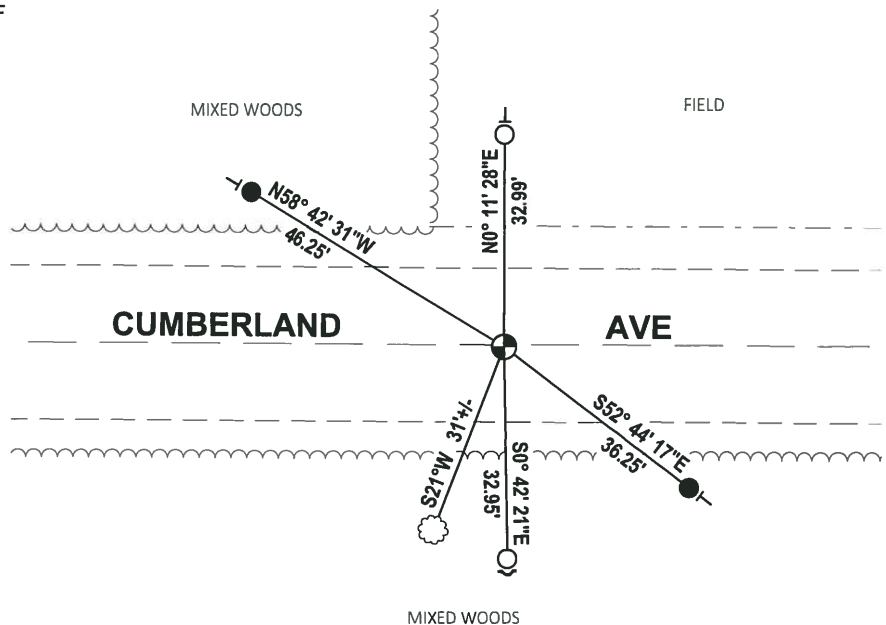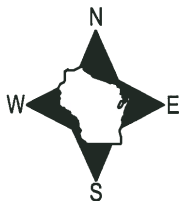


- SET 3/4" x 18" IRON REBAR, 1.50#/FT
- FOUND 3/4" IRON ROD
- ⊕ FOUND HARRISON MONUMENT
- ↗ STEEL FENCE POST
- └ VINYL "T" POST
- ☁ WITNESS TREE

Government Land Corner Certificate

ADAMS County
 TYPE OF MONUMENT: P.K. NAIL in Bituminous - Harr. to be set in
 STATE PLANE COORDINATES: N _____ Spring "79
 E _____

CORNER NO. 64
 SECTION 20
 TOWN 18N.
 RANGE 5E

ELEVATION — M.S.L. DATUM: _____
 THETA ANGLE: _____
 FIELD BOOK: 57 PAGE 88
 DRAWN BY: JOHN S. KEDROWSKI

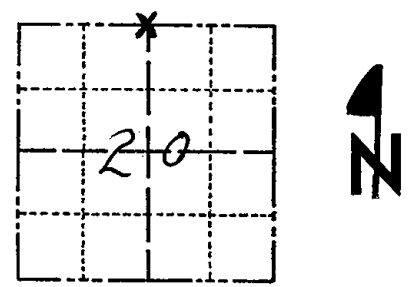


LOCATION
(Indicated by 'X')

BASIS FOR MONUMENT LOCATION

Show info such as: History of corner, with reference to Vol. and pg., dates, surveyor; exact description of monument replaced; if location computed, by taped or EDM traverse; landowner remarks, etc. (Use reverse side if necessary)

A. B. Kiedrowski dug with backhoe and found bottom 15" of a 4" diameter wood post (rotted). The post was accepted as the corner. (Painted)

SEAL:

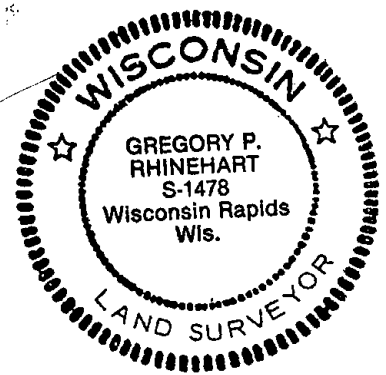


DATA SHOWN HERE ON
CERTIFIED CORRECT:

Gregory P Rhinehart
Registered Land Surveyor

DATE: Jan 2, 79

TIE SKETCH

Show at least four ties, also fence lines, roads, topo, size and type of witness trees' and if off road - best way to arrive at corner.

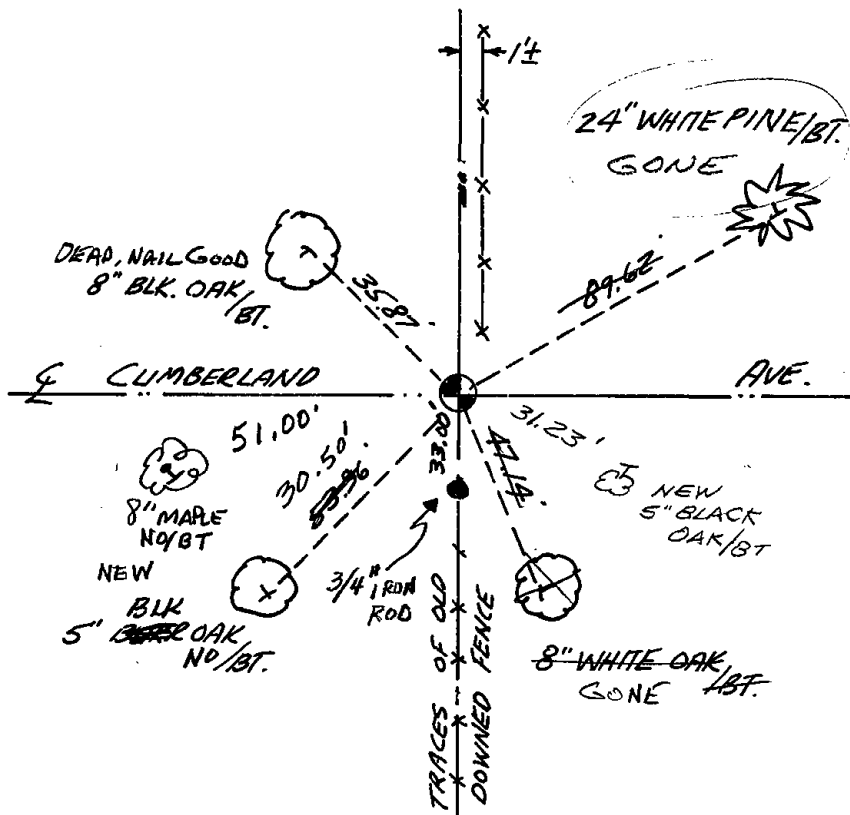

MAINTENANCE RECORD

Date	Init.	Remarks
3-1-83	GR-SS	1 ^{TIE} GONE - ADD 1
8-21-92	JG-BS	1-TIE GONE, MON. OK
2-5-98	JG	1-NEW
5-1-03	JG	1-GONE, 2-NEW
12-13-07	JG	OK