

30 SECTION 18 TOWN 05 RANGE

ADAMS COUNTY

COUNTY CORNER NO: 102
ROMPORTOL ID: 41805300020

PUBLIC LAND SURVEY MONUMENT RECORD

TYPE OF MONUMENT: HARRISON
ADAMS COUNTY COORDINATES, NAD 83 (2007)

N. 229429.078
E. 496722.535


ELEVATION- - - - DATUM - - - -

FIELD WORK DATE: 11/21/2018

BASIS FOR MONUMENT LOCATION

1975 - PLS 1103 RAN A EDM/TRANSIT TRAVERSE AROUND SECTION 32 AND TO ADJACENT SECTION CORNERS TO DETERMINE SEARCH AREAS. EXCAVATION WITH A BACKHOE YIELDED NO EVIDENCE OF THE ORIGINAL CORNER OR ANY REMONUMENTATION. CALCULATED THE CORNER LOCATION PROPORTIONALLY AND ON LINE BETWEEN ADJACENT SECTION CORNERS.

2018 - PLS 2675 FOUND A HARRISON MONUMENT 6" BELOW THE ROAD SURFACE AND 2 TIES. THE MONUMENT AGREES WITH THE EXISTING TIES. ACCEPTED THE HARRISON MONUMENT AS THE CORNER LOCATION. SET 2 NEW TIES AND MEASURED TO THE TIES.

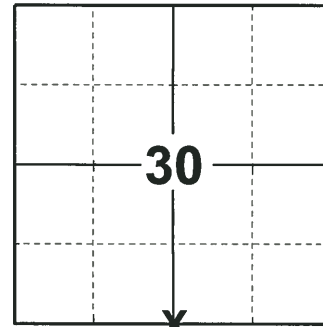

LOCATION

(INDICATE CORNER BY "X")

SEAL:





DATA SHOWN HERE ON THIS TIE SHEET IS CORRECT AND COMPLETE TO THE BEST OF MY KNOWLEDGE AND BELIEF.

PROFESSIONAL LAND SURVEYOR

DATE 12/4/2018

- TIE SKETCH

NOTE: THE CORNER FALLS 2± SOUTH OF THE CENTERLINE OF CZECH AVE.

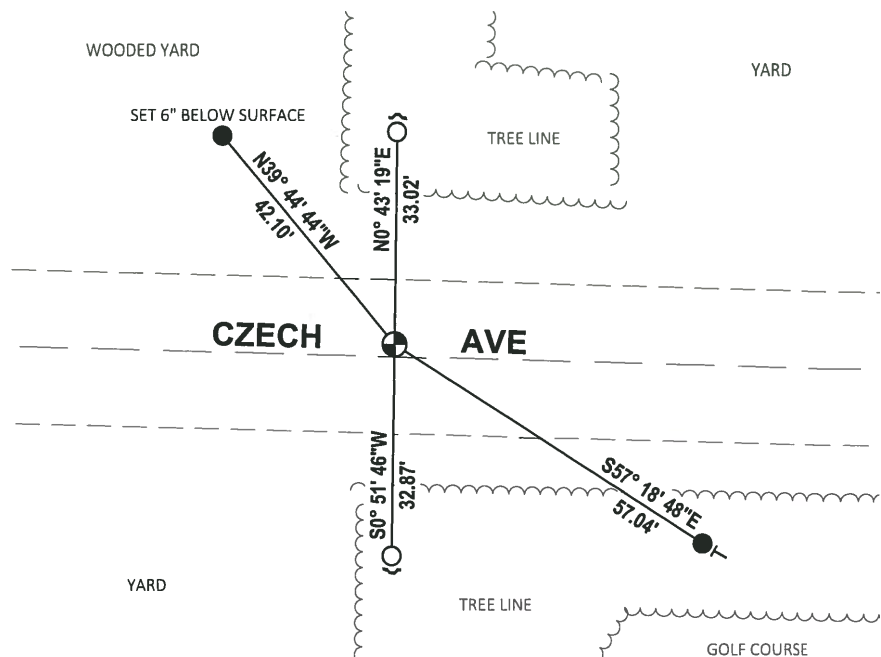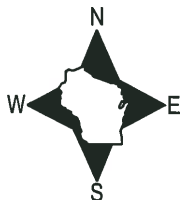

- SET 3/4" x 18" IRON REBAR, 1.50#/FT
- FOUND 3/4" IRON ROD
- ⊕ FOUND HARRISON MONUMENT
- ↗ STEEL FENCE POST
- ↖ VINYL "T" POST

ADAMS COUNTY

Survey Monument Record

TYPE OF MONUMENT: Standard Harrison

STATE PLANE COORDINATES: N _____


E _____

ELEVATION — M.S.L. DATUM: _____

THETA ANGLE: _____

FIELD BOOK: _____ PAGE _____

CORNER NO. 791
SECTION 30
TOWN 18
RANGE 5

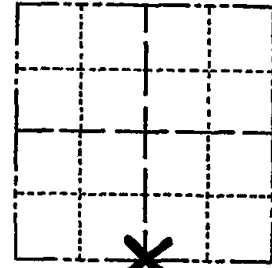

LOCATION
(Indicated by 'X')

SEAL:

BASIS FOR MONUMENT LOCATION


(Use reverse side if necessary)

Show info such as: History of corner, with reference to Vol. and pg, dates, surveyor; exact description of monument replaced; if location computed, by taped or EDM traverse; landowner remarks, etc.

Ran EDM/transit traverse around Section 32 and to adjacent section corners to determine search areas.

Excavation with backhoe yielded no evidence of the original corner or any remonumentation.

Set corner proportionally and on line between adjacent section corners.

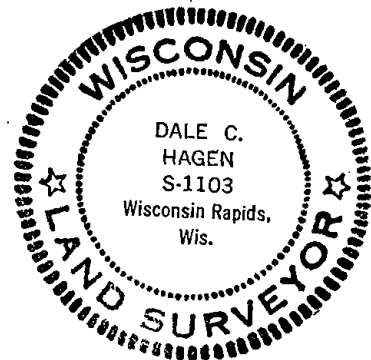

CERTIFIED CORRECT


Dale Hagen
Registered Land Surveyor

DATE: August 7, 1975

- OK 11-17-78 RN-SS
- OK 3-1-83 GR-SS
- OK 8-20-92 JG
- OK 2-4-98-JG
- 1-GONE, 1-NEW, 1-30-03-JG

TIE SKETCH

(Show at least four ties)

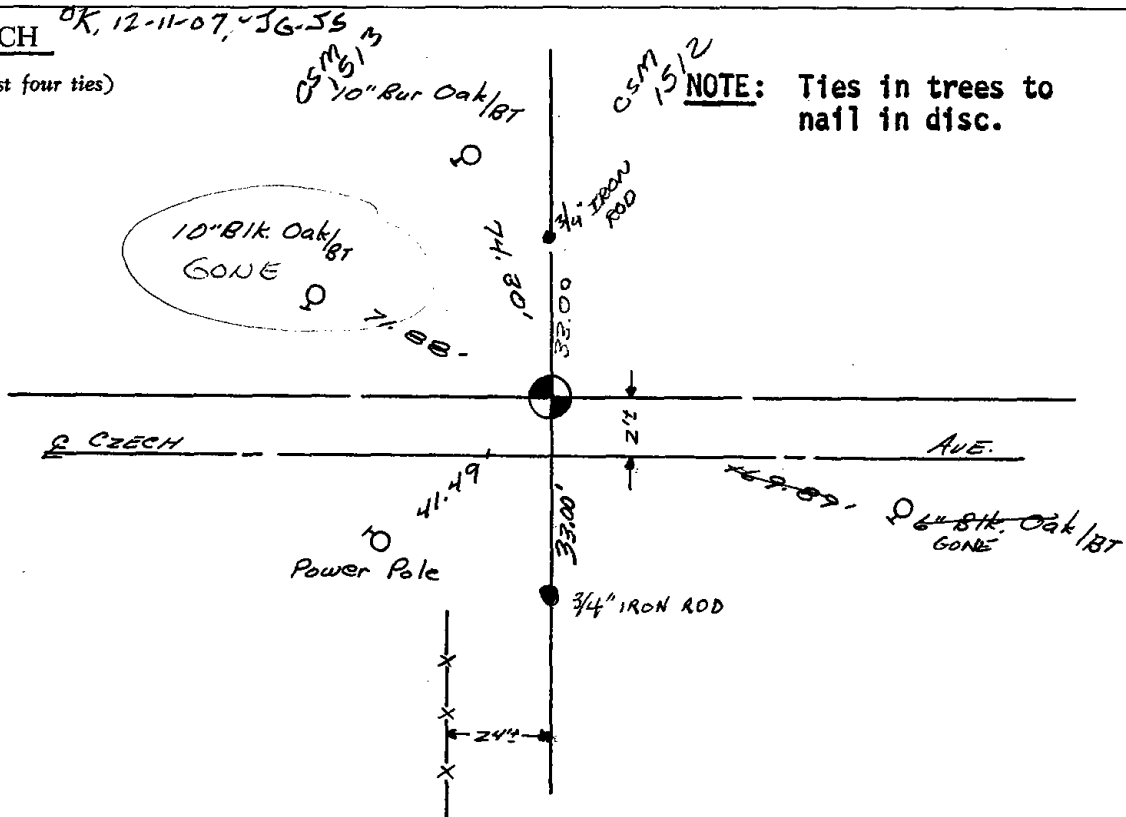

NOTE: Ties in trees to nail in disc.

